

Name Mr. Henry Jackson

Service No. ~~00~~ 2353

Address

13 B Revere St
~~10 Claine Street~~

Location Garden Service- Revere Street

Kind of Pipe

Size

Size of Main

Repair Renewal New Service

Location

Date
1941

Material

Amount

Total

Date

Amount

July 17,
Sum of 2/21/41

4 hrs. @ 60¢	2 40
10% Overhead	24
13# 1" Copper tubing @ 22¢	
1 1" C x I S. & W.	2 50
1 1" C x I Union	70
1 1" Space Nipple	32
1 1" C. Meter Stand	4 00
2' 20" Clay Pipe @ 1.50	3 00
1 Pit Cover	4 10
1 hr. trucking @ 75¢	75

\$20 87

Oct 3 1941 Paid

20 87

8/13/41 Bill sent.

Labor

TOWN OF LEXINGTON—BOARD OF PUBLIC WORKS

WATER DIVISION

The undersigned applies for a supply of water at No. _____ St. and hereby agrees to comply with the rules and regulations as now, or at any future time, established by the Board of Selectmen.

Am't. of Estimate \$ _____


Owner _____

Am't. Paid \$ _____

Address _____

Builder _____

Sketch of Service Here

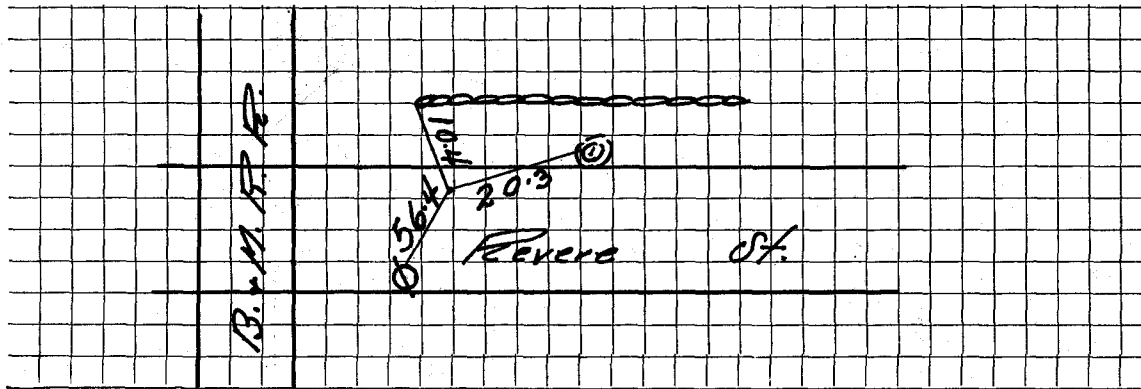

Connection made in _____ Street.

Work completed _____ 19

Remarks: