


DATE _____

TOWN OF LEXINGTON — BOARD OF PUBLIC WORKS

WATER DIVISION

Sketch of Service Here

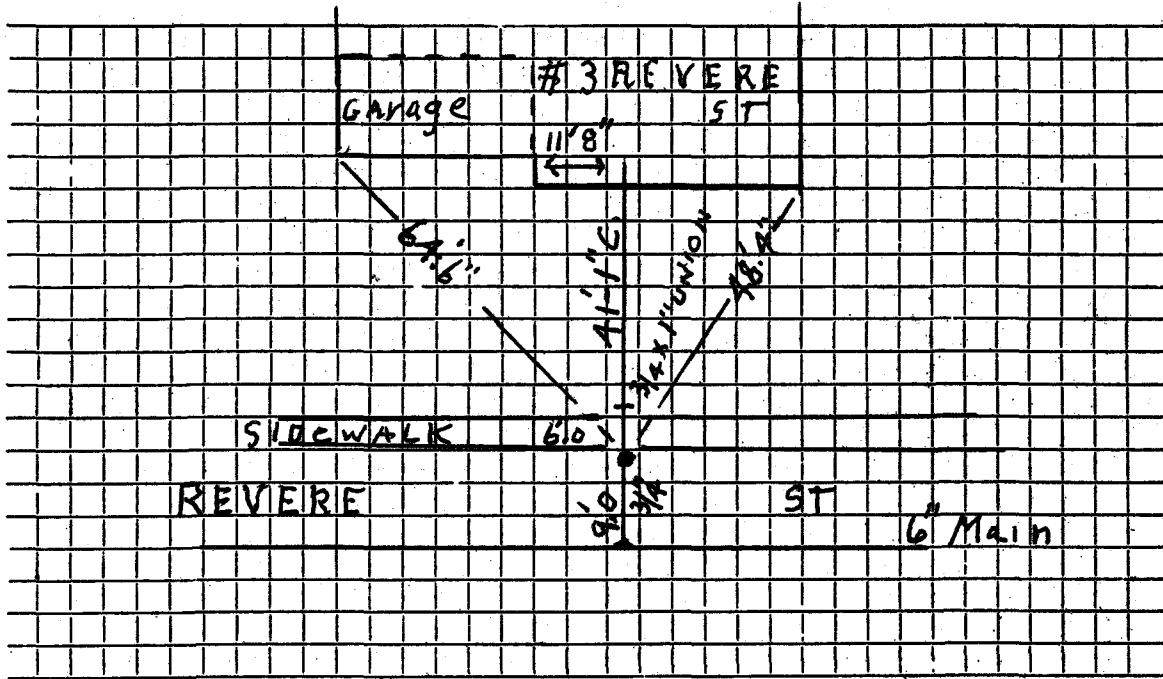

Connection made in Street.

Work completed 6/5/06 J. McLaughlin

Remarks: 6' of 3/4" Copper curb to 3/4" Union