

WATER SERVICE RECORD

#2971

Name Gerard Friel

Service No. 70

Address 30 Revere Street

Location

~~REPAIR & RENEWAL~~ New Service

Com. 5-3-54


Date	Material	Amount	Total	Date	Amount
4/9/54	Labor	1 85		4-5-54 - Deposited	55 00
	10% overhead	19	2 04	5-3-54 - Refunded	(27 21)
	60'-3/4" Copper tubing @.35		21 00		<u>NON CHARGE</u>
	1- 3/4" Cx 1/2" I.W.H. Stop & waste		4 00	4/9/54	Labor
	1 hr trucking		75		22'-3/4" Copper tubing @.35
	Patching 20 x 3		20 00		1'-3/4" C.Corp cock
			47 79		1-3/4" Qx3/4" C.curb cock
	TRENCH DUG BY OWNER:				1- Box & rod
					1- 1/2" Straight tail piece
					1- 1/2" Offset tail piece
					1 hr Littlefield shovel
					1 hr trucking
					<u>75</u>
					33 47

DATE _____

TOWN OF LEXINGTON — BOARD OF PUBLIC WORKS

WATER DIVISION

Sketch of Service Here

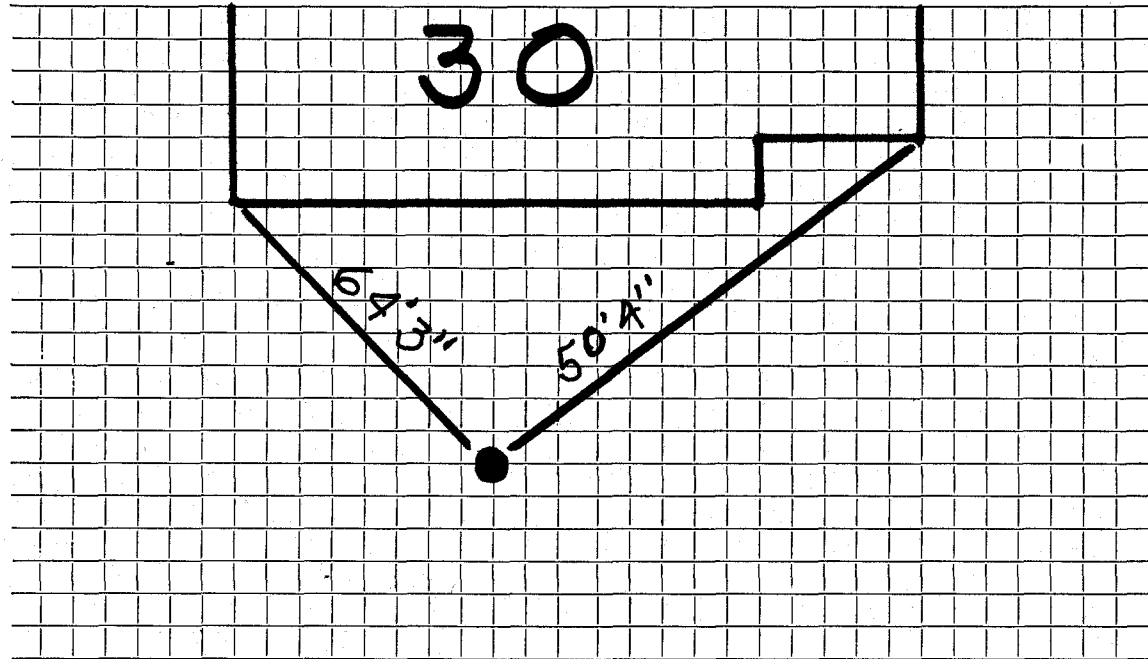

Connection made in Street. Work completed

Remarks:
.....
.....