

WATER SERVICE RECORD

#1652
#1884
41

Name Dianne Estates

Service No.

Address 3 1/4 Revere Street

Location

Repair ~~XXXXXX~~ Renewal ~~XXXXXX~~ New Service

Com. 5-3-54


Date	Material	Amount	Total	Date	Amount
3/12/54	Labor	3 50		3-9-54	Deposited 75 00
	10% overhead	35	3 85	5-3-54	Refunded (21 18)
	90' 3/4" Copper tubing @.35		31 50		NON CHARGE 53 82
	1- 3/4" CX 1/2 I.W.H. Stop & waste		4 00	3/12/54	Labor 15 50
	1-3/4" Cx3/4" C Union (3 parts)		1 72	20' 3/4" Copper tubing @.35	7 00
	1 hr trucking		75	1-3/4" C. Corp Cock	4 33
	Patching 12 x 3		12 00	1-3/4" Cx3/4" C. curb cock	4 67
			53 82	1- Box & rod	3 90
				1- 1/2 Straight tail piece	50
	Trench dug by owner			1- 1/2 Offset tail piece	50
				4 hrs. Littlefield shovel @.750	30 00
				1 hr trucking	75
					67 15

DATE _____

TOWN OF LEXINGTON — BOARD OF PUBLIC WORKS

WATER DIVISION

Sketch of Service Here

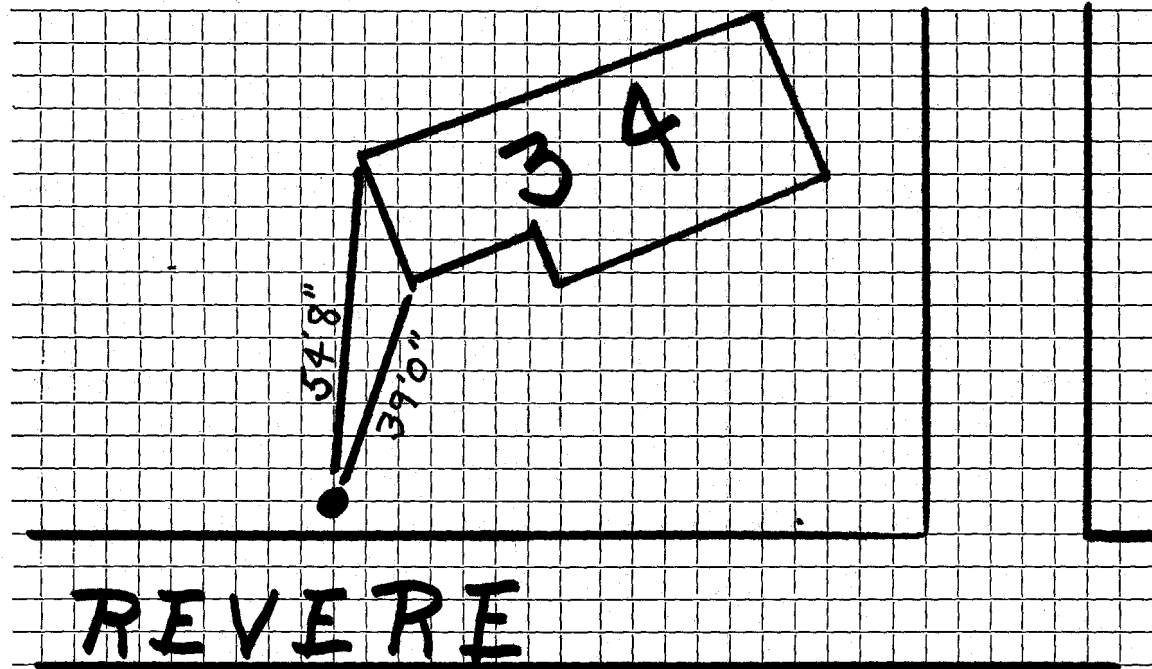

Connection made in Street. Work completed

Remarks:

.....

.....