

WATER SERVICE RECORD

Name

Service No.

Address **38 REVERE ST**

Location

Repair—Renewal—New Service


Date		Material	Amount	Total	Date	Material	Amount
Outside							
6-4-	86	1- 3/4" CORP.					
		1- 3/4" CURB w/BOX					
		9.3 LF 3/4" COPPER			7-12-	50	Inside
						55'	3/4" Copper
						1	3/4" C. X 1/2" l. W. H. S Top & Waste

DATE _____

TOWN OF LEXINGTON — BOARD OF PUBLIC WORKS

WATER DIVISION

Sketch of Service Here

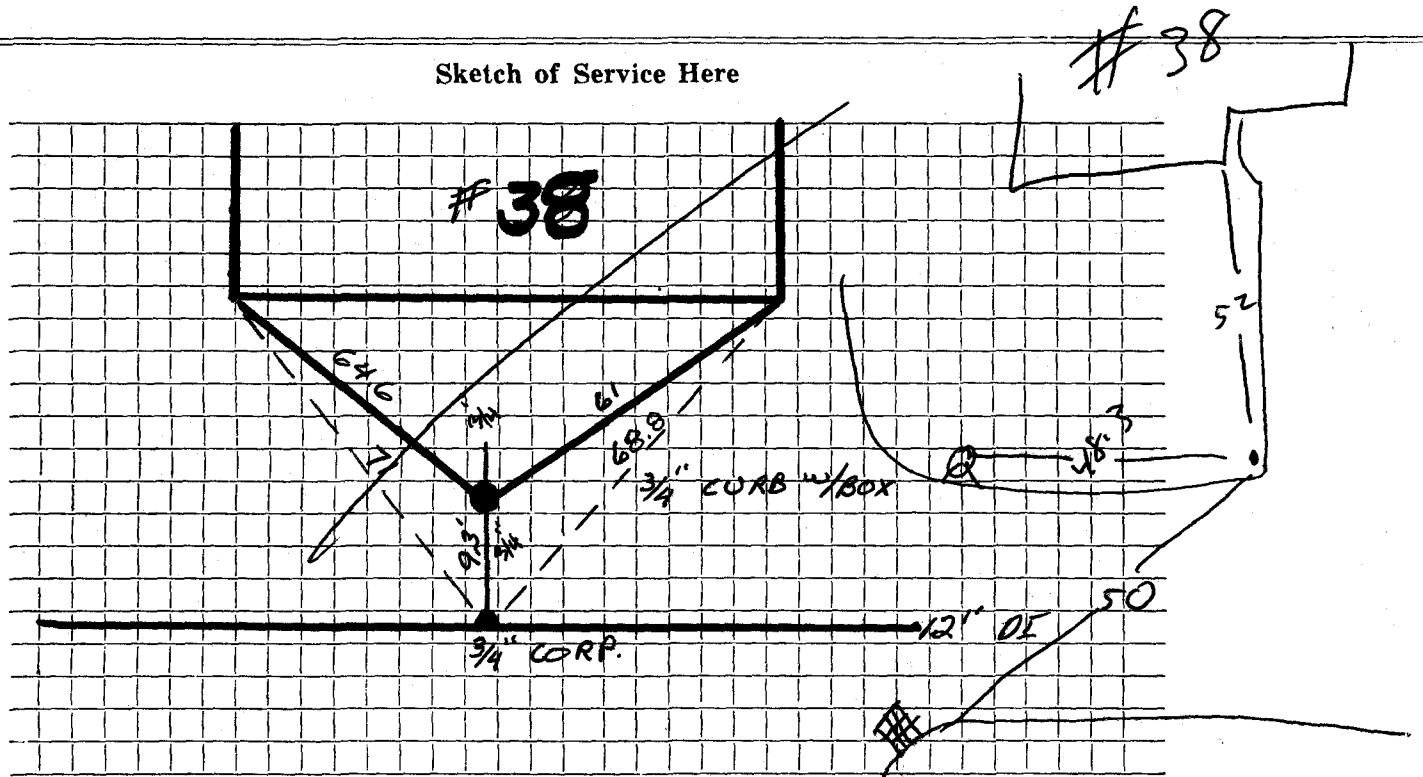

Connection made in REVERSE Street, Work completed 6-4-86

Remarks: NEW 12" DI MAIN, NEW 3/4" SERV. TO CURB.

curb in backhaul waste on street side