

WATER SERVICE RECORD

Name

Service No.

Address 4 Revere Street

Location

Repair - ~~Stopcock~~


Date	Material	Amount	Total	Date	Material	Amount
9-28-48						
	1 3/4" C. X 1/2" I.W.H. Stop + Waste					
					CURB TO MAIN	
				9-2-64	Labor	10.80
					10% O.H.	1.08
						11.88
					25' 3/4" Cop. tubing @ .42	6.30
					1 3 part union	2.41
					1 Hr. Town truck @ 3.00	3.00
						23.59
					(Broken by contractor)	
				9-28-48		
					26' 3/4" Copper	
					1 3/4" C. Corp Cack	
					1 3/4" C. X 3/4" C. Curb Cack	
					1 Box + Rod	

DATE _____

TOWN OF LEXINGTON — BOARD OF PUBLIC WORKS

WATER DIVISION

Sketch of Service Here

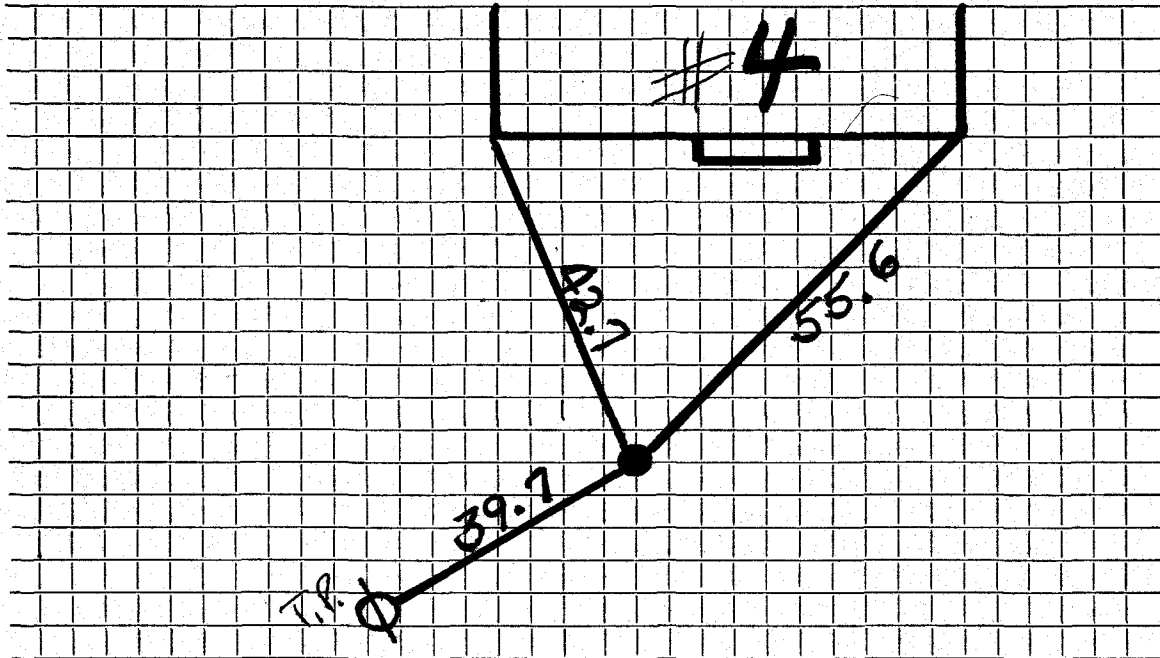

Connection made in Street. Work completed

Remarks:

.....

.....