

Name Colonial Building Corporation

6655 A

Service No. 65 3164

Address 6 Revere Street

#6070

Lexington, Mass.

Location 6 Revere Street

Kind of Pipe

Size

Size of Main

~~Repair~~ ~~Renewal~~ - New Service

Com 12-30-46

Location

Date	Material	Amount	Total	Date	Location	Amount
Aug. 30, '46	Labor	3 44	3 44	Jul 22 '46	<i>Deposited and Non-Charge</i>	45 00
	10% Overhead		35	Jan 13 '47		5 76
	112' - $\frac{3}{4}$ " Copper Tubing @.23		25 76			50 76
	1 - $\frac{3}{4}$ " C x $\frac{1}{2}$ " I.W.H. S & W		2 82	Jul. 23, '46	Labor	11 30
	2 - $\frac{3}{4}$ " C x $\frac{3}{4}$ " C Unions (3 parts)		2 64	24, '46	"	19 14
	Patching 15' x 3'		15 00	17' - $\frac{3}{4}$ " Copper Tubing @.23		3 91
	Trucking 1 hr. @.75		75	1 - $\frac{3}{4}$ " C Corp-cock		2 70
			50 76	1 - $\frac{3}{4}$ " C x $\frac{3}{4}$ " C Curb-cock		3 30
	<u>Trench Dug by Owner</u>			1 - Box & Rod		3 35
				1 - $\frac{1}{2}$ " Offset Tail Piece		50
				1 - $\frac{1}{2}$ " Straight Tail Piece		50
				Compressor 1 hr. @1.75		1 75
	Labor			Trucking 1 hr. @.75		75
						47 20

Hadley Press, Inc., Lexington

TOWN OF LEXINGTON—BOARD OF PUBLIC WORKS

WATER DIVISION

The undersigned applies for a supply of water at No. _____ St. and hereby agrees to comply with the rules and regulations as now, or at any future time, established by the Board of Selectmen.

Am't. of Estimate \$ _____

Owner


*Colonial Building Corporation
by Theodore G. Freeman Pres*

Am't. Paid \$ _____

Address

*7 Cutting St.
Winchester*

Builder _____

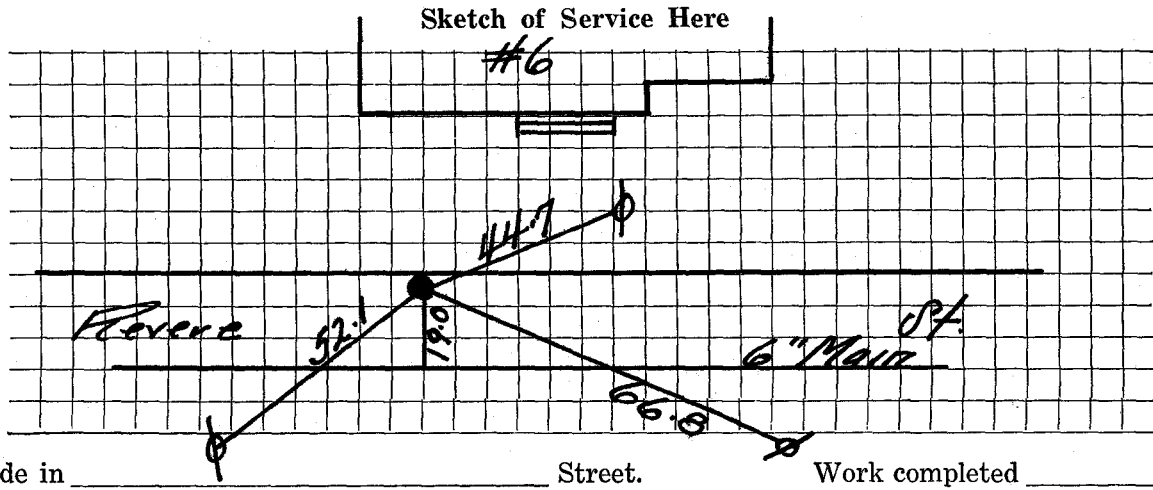

Connection made in _____

Street.

Work completed _____

19

Remarks: