

Name

James Wilson

## WATER SERVICE RECORD

# 4969

Service No. 110

Address

8 Revere Street

Location

Lexington, Mass.

~~Repair Renewal~~ - New Service


Com 9-24-51

Date	Material	Amount	Total	Date	Amount
7-10-51	Labor	5 18	5 18	6-24-51 Deposited	75 -
	10% Overhead		52	9-24-51 Refunded <del>XXXXXXXXXX</del>	9 99
	60'-3/4" Copper Tubing @.326	19 56	19 56	12-14-51 <del>XXXXXXXXXXXXXXXXXXXX</del>	45 00
	1-3/4" Cx 1/2 I.W?H. S&W		4.00		No Charge
	2 Hrs. Littlefield Shovel		14 00	7-10-51 Labor	5 52
	1 Hr. Trucking		75	30'-3/4" Copper Tubing	9 78
	Patching 21x3		21 00	1-3/4" C Corp-Cock	4 33
			65 01	1-3/4" Cx 3/4" C Curba Cock	4 67
				1 Box & Rod	4 68
				1-1/2 Offset Tail Piece	50
				1-1/2 Straight Tail Piece	50
				2 Hr. Littlefield Shovel	14 00
				1 Hr. Trucking	75
					44 73
				9.99 refunded on 9-24-51 to England Inst. by mistake, error corrected & 8.99 refunded to Wilson 12-14-51	

DATE \_\_\_\_\_

TOWN OF LEXINGTON — BOARD OF PUBLIC WORKS  
WATER DIVISION

Sketch of Service Here

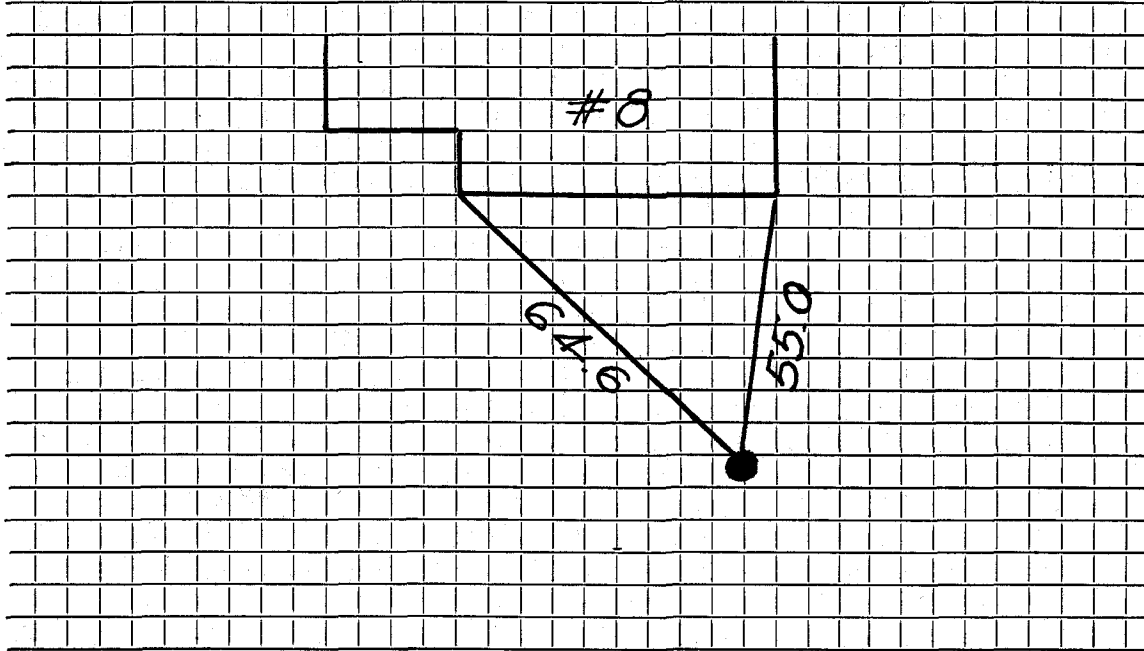

Connection made in ..... Street. Work completed .....

Remarks: .....

.....

.....