

WATER SERVICE RECORD

Name **Alfred Tutin**Service No. **255**Address **9 Revere Street**# **542 - # 562**


Location

Repair—~~Renewal~~ **New Service Renewal***Comm. 12-14-60*

Date	Material	Amount	Total	Date	Amount	
11-4-60	Labor	23 10		10-27-60	Deposit	150 00
	10% O.H.	2 31	25 41	12-12-60	Returned	16 55
	58' 3/4" Copper tubing @.42		24 36			81 44
	1 3/4" CX1/2 I.W.H. Stop & Waste	6 17			NON CHARGE	
	3 Hrs. Pippin Shovel @ 6.50	19 50		4/6/56	Labor	27 73
	2 Hrs. Trucking @3.00	6 00		5 Hrs. Littlefield Shov. @8.50		42 50
			81 44	1 3/4 Brass Nipple 4"		18
10/18/61	3' 3/4 Copper			1 1" x 3/4 Brass Red Coupling		1 51
	1 3/4 Comp Union			1 1" Cement Lined Nipple 6"		21
				1 1" Repair Clamp		1 60
						73 73
				1 1/2 Straight tailpiece		50
				1 1/2 offset tailpiece		50
						74 73

TOWN OF LEXINGTON — BOARD OF PUBLIC WORKS
WATER DIVISION

Sketch of Service Here

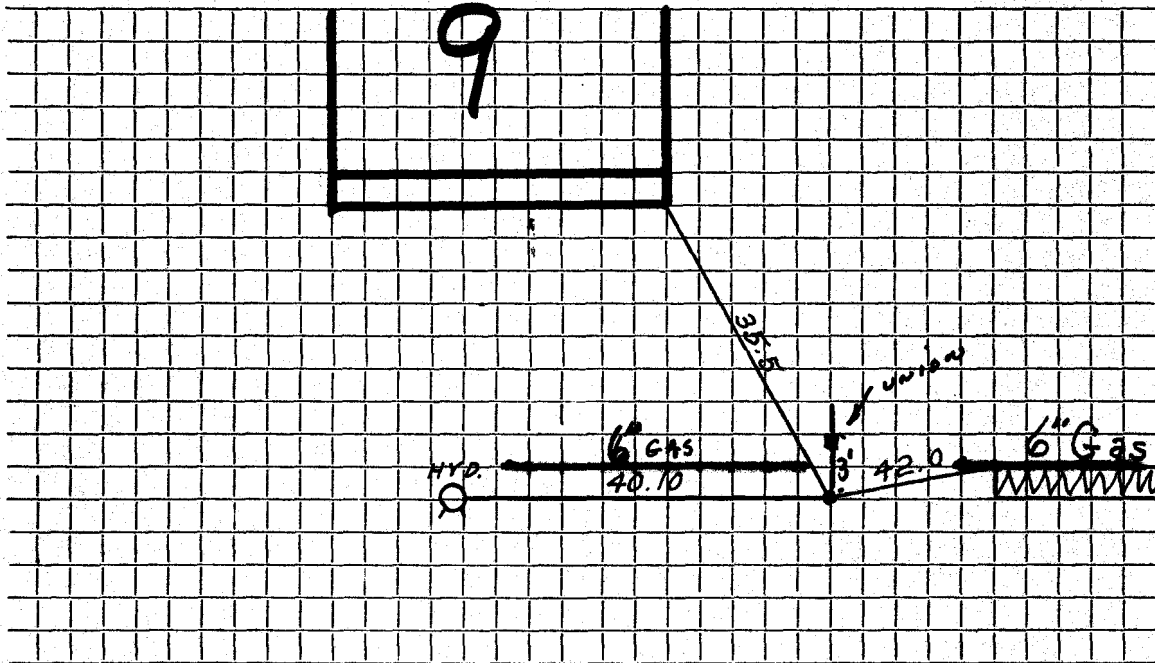

Connection made in Street. Work completed

Remarks:

.....

.....