

Name Ross Realty Corp.,

Service No. #2355

Address ~~173 Bedford Street~~

#982

1 Revolutionary Rd.  
Apt 39

Location

1 Revolutionary Rd., Lot 99

Kind of Pipe

Size

Size of Main

~~Repair - Renewal~~ - New Service

Location

Date  
1941

Material

Amount

Total

Date

Amount

July 19  
*Sum 8/20/41*

2 hrs. @ 60¢ 1 20  
10% Overhead 12  
47' 3/4" Copper tubing @ 19¢ 8 93  
1 3/4" C. Union (3 parts) 90  
1 3/4" C x I S. & W. 2 25  
1 hr. trucking @ 75

14 15

July 21, 1941 Deposited  
August 20, 1941 Refunded

20 00  
5 85  
14 15

*Refund credited to Water Service #49  
(132 #9  
4.53 #95)*

Labor

DATE \_\_\_\_\_

# TOWN OF LEXINGTON—BOARD OF PUBLIC WORKS

## WATER DIVISION

The undersigned applies for a supply of water at No. \_\_\_\_\_ St. and hereby agrees to comply with the rules and regulations as now, or at any future time, established by the Board of Selectmen.

Am't. of Estimate \$ \_\_\_\_\_


Owner \_\_\_\_\_

Am't. Paid \$ \_\_\_\_\_

Address \_\_\_\_\_

Builder \_\_\_\_\_

Sketch of Service Here

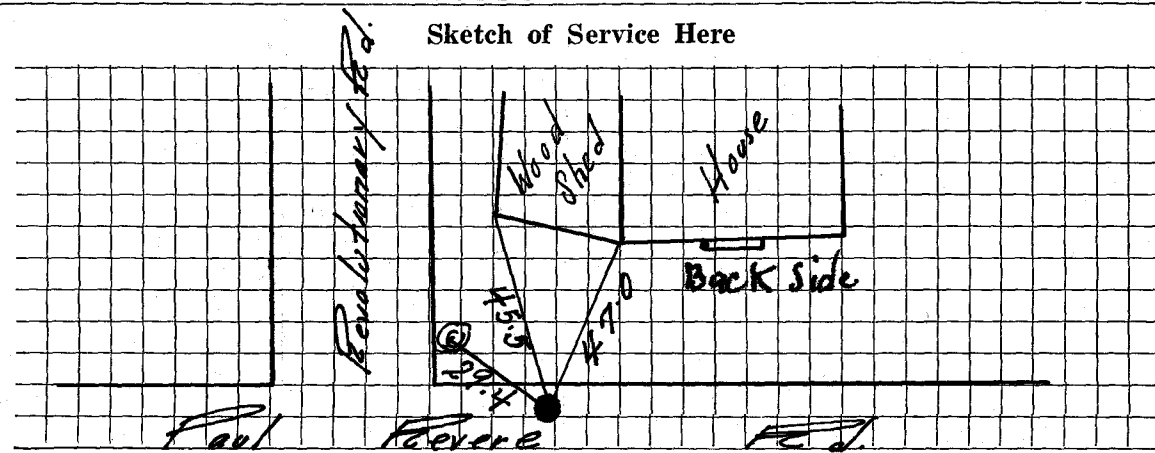

Connection made in \_\_\_\_\_ Street.

Work completed \_\_\_\_\_ 19

Remarks: