

WATER SERVICE RECORD

Name Arthur Mitchell

Service No. 331

Address 10 Revolutionary Rd.

Location Lexington

Repair ~~Renewal~~ New Service Com. 12-29-52


Date	Material	Amount	Total	Date	Amount
12/18/52	Labor	3 19		12-3-52 Deposited	50 00
	10% Overhead	32	3 51	12-29-52 Refunded	(14 48)
	39'-3/4" Copper tubing @.34	13 26			NON CHARGE 25 52
	1-3/4" Cx 1/2 I.W.H. stop&waste	4 00		12/18/52 Labor	3 19
	2 Hrs Littlefield shovel	7 00		10'-3/4" Copper Tubing @.34	3 40
	1 Hr. Trucking		75	1-3/4" C. corp-cock	4 33
			35 52	1-3/4" C. x 3/4" C. Curb-cock	4 67
				1-Box & Rod	3 90
				1-1/2 offset tail pc.	50
				1-1/2 straight tail pc.	50
				1 Hr Littlefield shovel	7 00
				1 Hr. trucking	75
					28 24

DATE \_\_\_\_\_

TOWN OF LEXINGTON — BOARD OF PUBLIC WORKS

**WATER DIVISION**

Sketch of Service Here

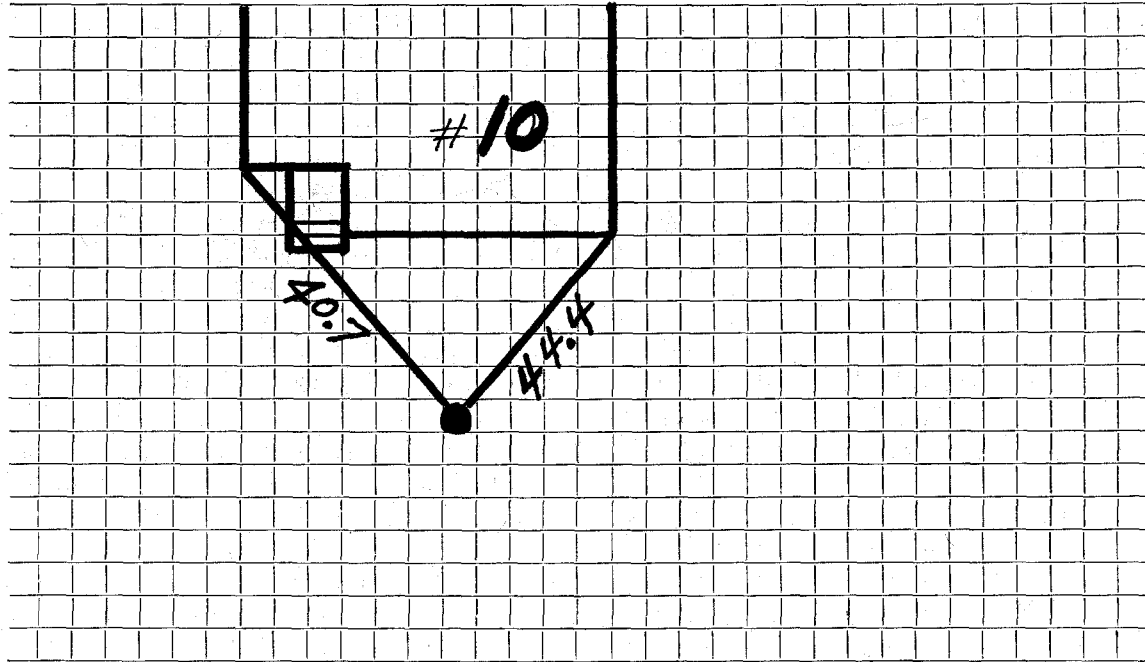

Connection made in ..... Street.                      Work completed .....

Remarks: .....  
.....  
.....