

WATER SERVICE RECORD

# 4347

Name James W. Coveney

Service No. 376

Address 12 Revolutionary Road

Location Lexington, Mass.

~~Repair-Renewal~~ - New Service


Com. 12-31-50

Date	Material	Amount	Total	Date	Amount
Dec. 15, '50	Labor	2 60	2 60	Dec. 8, '50	40 00
	10% Overhead		226		
	40' - 3/4" Copper Tubing @.334	13 36			No Charge
	1 - 3/4"C x 1/2" I.W.H. S&W	3 76			34 73
	Littlefield Shovel 2 hrs. @7.00	14 00		Dec. 15, '50	Labor
	Trucking 1 hr. @.75		75		2 60
4-4-61			34 73		15' - 3/4" Copper Tubing @.334
	1' 3/4" Copper				5 01
	2 3/4"C. - 3 Part Union				1 - 3/4"C Corp-cock
					3 60
					1 - 3/4"C x 3/4"C Curb-cock
					4 40
					1 - Box & Rod
					3 70
					1 - 1/2" Straight Tail Piece
					42
					1 - 1/2" Offset Tail Piece
					42
					Littlefield Shovel 1 hr. @ 7.00
					7 00
					Trucking 1 hr. @.75
					75
					27 90

DATE \_\_\_\_\_

TOWN OF LEXINGTON — BOARD OF PUBLIC WORKS  
WATER DIVISION

Sketch of Service Here

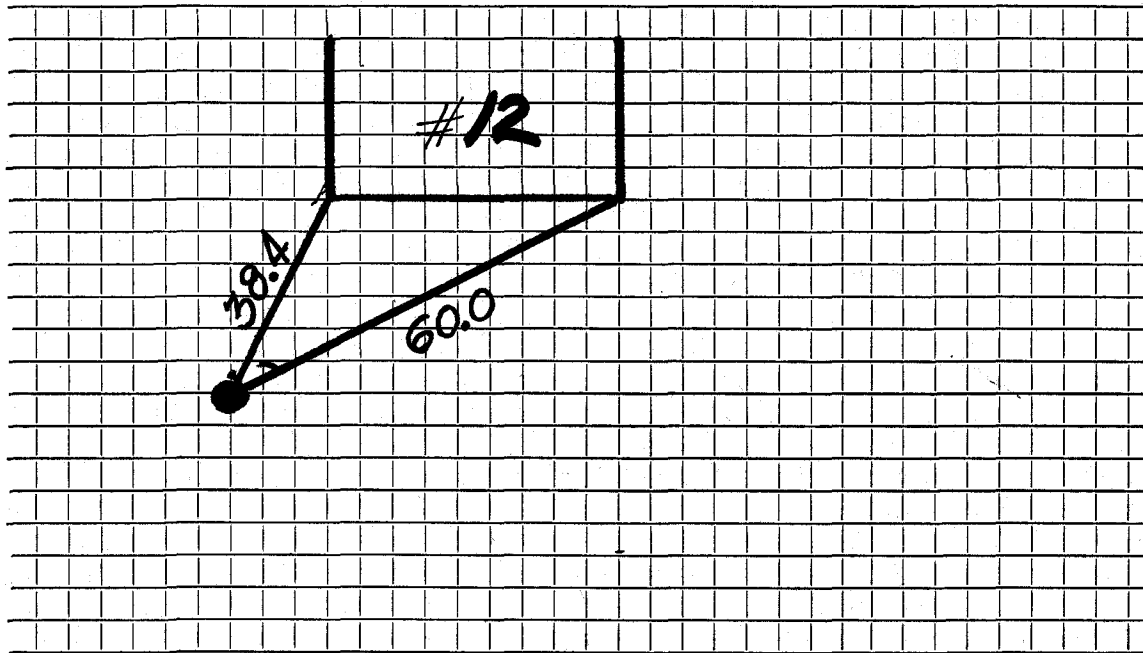

Connection made in ..... Street. Work completed .....

Remarks: .....  
.....  
.....