

Name Vern Clark

Service No. 158
#4772

Address 3 Revolutionary Road

Lexington, Mass.

Location 3 Revolutionary Road

Kind of Pipe

Size

Size of Main

~~Repair-Renewal~~ New Service

Location

Date

Material

Amount

Total

Date

Amount

Aug. 20, '48

Labor

3 25

3 25

Aug 16 48

Deposited

45 00

10% Overhead

33

41'-3/4" Copper Tubing

10 46

Non-Charge

26 26

1-3/4" C x 1/2" I.W.H. S & W

3 15

Aug. 20, '48 Labor

2 20

1-3/4" 6 x 3/4" C. Union (3 pts.)

1 32

21'-3/4" Copper Tubing

5 36

1 hr. Littlefield Shovel

7 00

1-3/4" C. Corp Cock

3 00

1 hr. Trucking

75

1-3/4" C x 3/4" C. Curb Cock

3 68

2 6 26

1-Box & Rod

3 55

Com. 10/25/48

1 hr. Littlefield Shovel

7 00

1-1/2" Offset Tail Piece

30

1-1/2" Straight Tail Piece

30

1 hr. Trucking

75

Labor

26 14

DATE _____

TOWN OF LEXINGTON—BOARD OF PUBLIC WORKS

WATER DIVISION

The undersigned applies for a supply of water at No. _____ St. and hereby agrees to comply with the rules and regulations as now, or at any future time, established by the Board of Selectmen.

Am't. of Estimate \$ _____


Owner _____

Am't. Paid \$ _____

Address _____

Builder _____

Sketch of Service Here

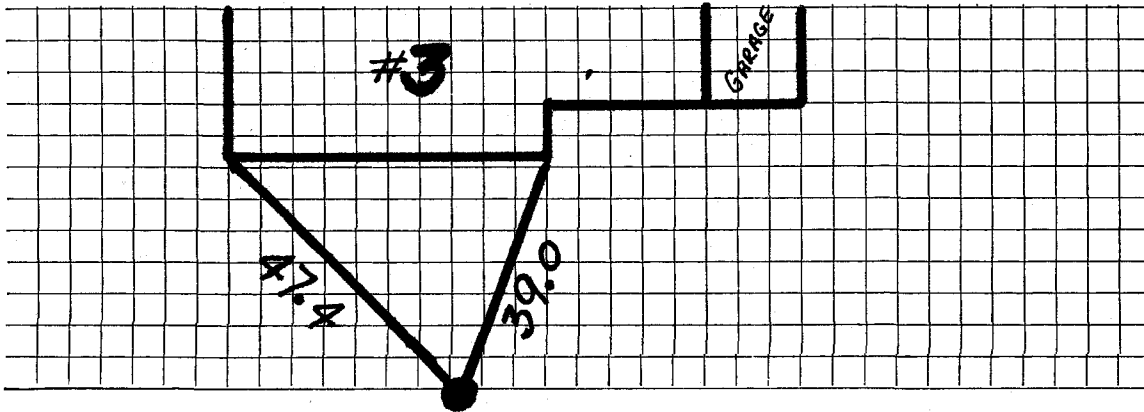

Connection made in _____ Street.

Work completed _____ 19

Remarks: