

WATER SERVICE RECORD

Name Richard Fontaine

Service No. 65

Address 4 Revolutionary Road

Location Lexington, Mass.

~~Repair - Removal -~~ New Service


Com. 8-6-51

Date	Material	Amount	Total	Date	Amount
Apr. 21 '51	Labor	2 98	2 98	4-14-51	Deposited 40 00
	10% Overhead		30		
	50' - 3/4" Copper Tubing @.36	18 00	18 00		No Charge
	1 - 3/4"C. x 1/2" I.W.H. S&W		1 00	Apr. 21 '51	Labor 3 75
	Littlefield Shovel 2 hrs. @ 7.00	14 00	14 00		18' - 3/4" Copper Tubing @.36 6 48
	Trucking 1 hr. @.75		75		1 - 3/4"C Corp-cock 4 33
			40 03		1 - Box & Rod 4 68
					1 - 3/4"C x 3/4"C Curb-cock 4 67
					1 - 1/2" Offset Tail Piece 50
					1 - 1/2" Straight Tail Piece 50
					Littlefield Shovel 1 hr. @7.00 7 00
					Trucking 1 hr. @.75 75
					32 66
					Bill sent 5-6-51 - nothing due

DATE _____

TOWN OF LEXINGTON — BOARD OF PUBLIC WORKS
WATER DIVISION

Sketch of Service Here

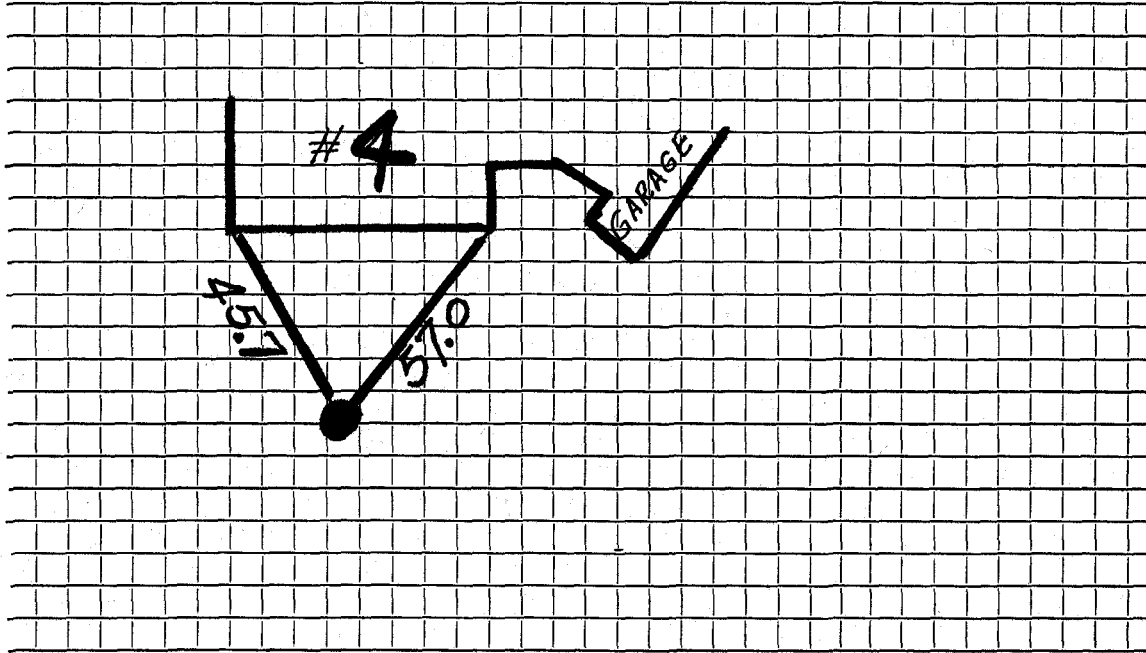

Connection made in Street. Work completed

Remarks:
.....
.....