

Name John Desmond

Service No. 254

Address 5 Revolutionary Road

Lexington, Mass.

Locatic 5 Revolutionary Road

Kind of Pipe

Size

Size of Main

~~Repair & Renewal~~ - New Service

Com. 11-6-50

Location

Date	Material	Amount	Total	Date	Location	Amount
Sept. 16, '50	Labor	2 60	2 60	Aug 18 '50	Deposited	40 00
	10% Overhead		26			
	48' - 3/4" Copper Tubing @.275		13 20		No Charge	34 67
	1 - 3/4" C x 1/2" I.W.H. S&W		3 76	Sept. 16, '50	Labor	5 05
	Littlefield Shovel 2 hrs. @7.00		14 00	22' - 3/4" Copper T.,bing @.275		6 05
	Trucking 1 hr. @.75		75	1 - 3/4" Corp-cock		3 60
			34 57	1 - 3/4" C x 3/4" Curb-cock		4 40
				1 - Box & Rod		3 35
				1 - 1/2" Straight Tail Piece		42
				1 - 1/2" Offset Tail Piece		42
				Littlefield Shovel 2 hrs. @7.00		14 00
				Trucking 1 hr. @.75		75
	<b>Labor</b>					38 04

DATE \_\_\_\_\_

# TOWN OF LEXINGTON—BOARD OF PUBLIC WORKS

## WATER DIVISION

The undersigned applies for a supply of water at No. \_\_\_\_\_ St. and hereby agrees to comply with the rules and regulations as now, or at any future time, established by the Board of Selectmen.

Am't. of Estimate \$ \_\_\_\_\_


Owner \_\_\_\_\_

Am't. Paid \$ \_\_\_\_\_

Address \_\_\_\_\_

Builder \_\_\_\_\_

Sketch of Service Here

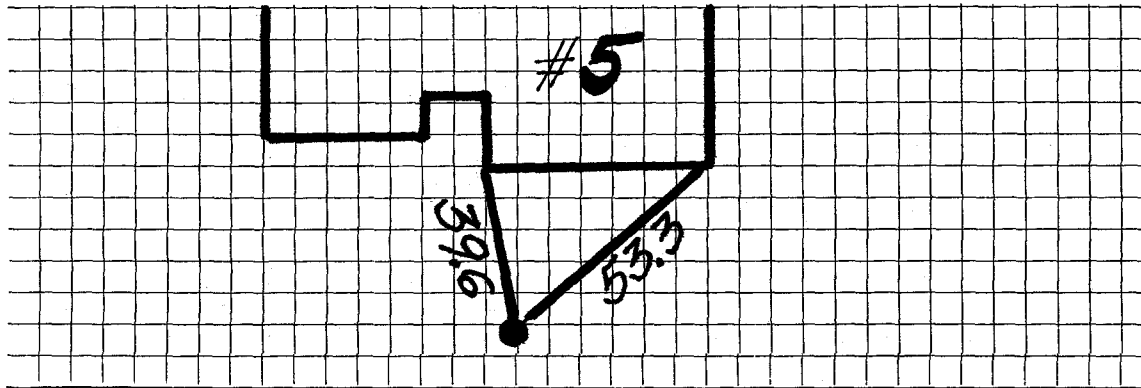

Connection made in \_\_\_\_\_ Street.

Work completed \_\_\_\_\_ 19

Remarks: