

WATER SERVICE RECORD

#4860

Name Michael McCarthy

Service No. 384

Address 6 Revolutionary Road

Location Lexington, Mass.

5 Jonathan Ct. Belmont Mass

~~Repair-Renewal~~ - New Service

Com. 12-31-50


Date	Material	Amount	Total	Date	Amount
Dec. 12, '50	Labor	2 60	2 60	Jan 15 '51	33 06
	10% Overhead		26		
	35' - 3/4" Copper Tubing @.334	11 69			No Charge
	1 - 3/4"C x 1/2" I.W.H. S&W	3 76		Dec. 12, '50	Labor 3 85
	Littlefield Shovel 2 hrs. @7.00	14 00			12' - 3/4" Copper Tubing @.334 4 01
	Trucking 1 hr. @.75		75		1 - 3/4"C Corp-cock 3 60
			33 06		1 - 3/4"C x 3/4"C Curb-cock 4 40
					1 - Box & Rod 3 35
					1 - 1/2" Straight Tail Piece 42
					1 - 1/2" Offset Tail Piece 42
					Littlefield Shovel 1 hr. @ 7.00 7 00
					Trucking 1 hr. @.75 75
					27 80

Bill sent 1-12-51

DATE _____

TOWN OF LEXINGTON — BOARD OF PUBLIC WORKS
WATER DIVISION

Sketch of Service Here

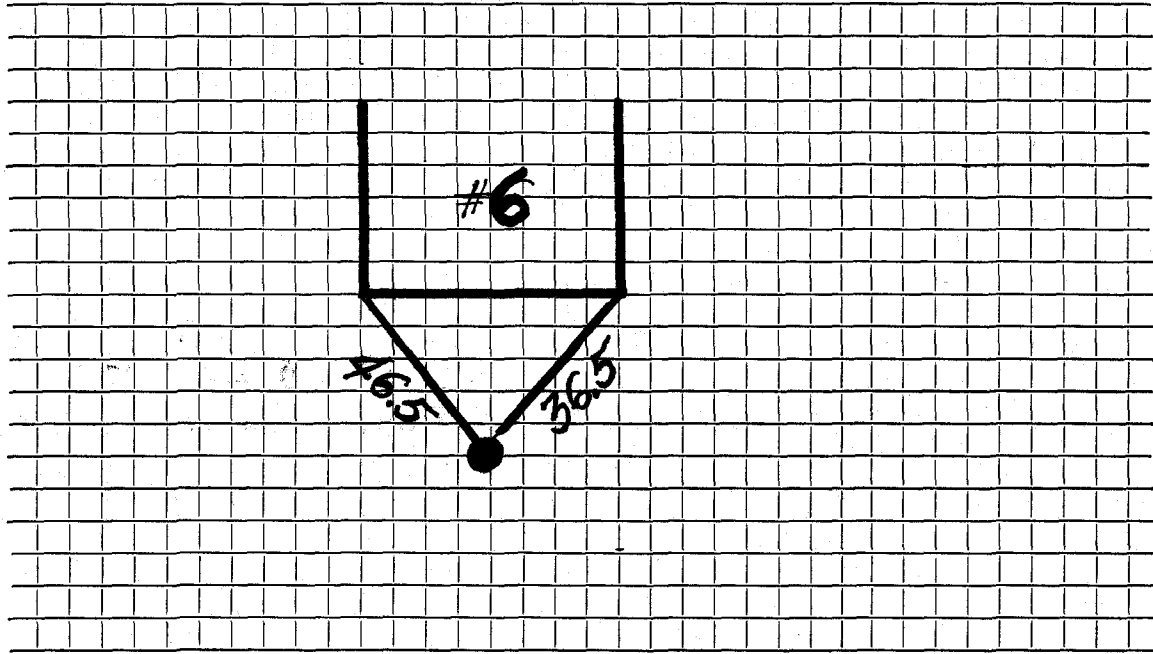

Connection made in Street. Work completed

Remarks:
.....
.....