

WATER SERVICE RECORD

Name Oscar Carlson

Service No. 109

Address 13 Richard Road.

# 671  
# 926

Location


~~REPAIR~~ New Service

Comm 10-19-59

Date	Material	Amount	Total	Date	Material	Amount
6-12-59	Labor	3.70		6-3-59	Deposit	50.00
	10% O.H.	.37	4.07	10-19-59	★ Refund	19.35
53'	3/4" Copper tubing @.3764		19.95			<u>30.65</u>
1	3/4" C x 1/2 I.W.H. Stop & Waste		5.88		NON CHARGE	
1	hr. Trucking @.75		.75		Labor	3.70
			<u>30.65</u>	20'	3/4" Copper tubing @.3764	7.53
				1	3/4" C Corp Cock	4.67
				1	3/4" C Curb Cock	6.07
				1	Box & Rod	5.00
				1	1/2 Straight tailpiece	.50
				1	1/2 Offset tailpiece	.50
						<u>27.97</u>
					OUTSIDE REPAIR (NON-CHARGE)	
				4-10-75	Labor	77.40
				4	Yds. Gravel @2.20	8.80
				1/2	Ton Cold Patch	3.05
				1	Patch 8' x 8'	43.56
				1	Hr. Trucking	3.00
				1	Hr. Backhoe	6.00
					Applied to Bill # 25	<u>\$142.41</u>

TOWN OF LEXINGTON — BOARD OF PUBLIC WORKS  
WATER DIVISION

Sketch of Service Here

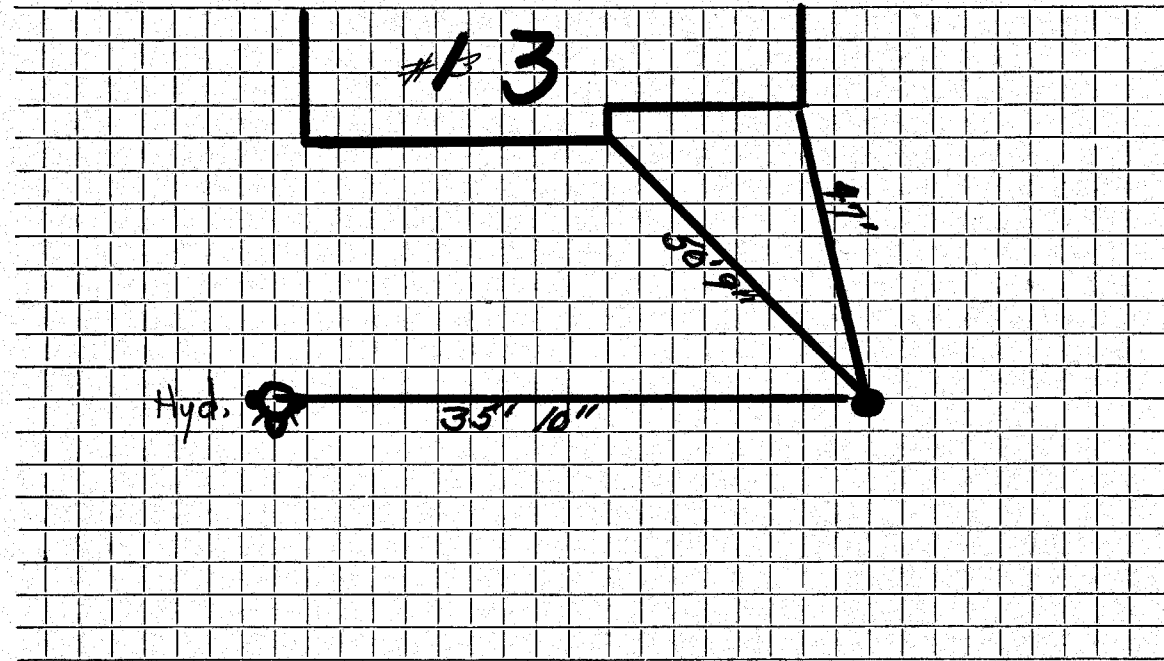

Connection made in ..... Street. Work completed .....

Remarks: .....  
.....  
.....