

WATER SERVICE RECORD

5204

Name C. Sykora

Service No. 204

Address 15 Richard Road

RD.

Location

Repairs: ~~General~~ - New Service

Comm 12-15-58


Date	Material	Amount	Total	Date	Amount	
10/8/58	Labor	3 70		10-1-58	Deposit	35 00
	10% overhead	37		1-19-59	Paid	13
			4 07			35 13
	60' 3/4" copper tubing @ .37		22 20		NON CHARGE	
	1 3/4" Cx 1/2 IWH stop & waste		5 84		labor	7 59
	1 3/4" C3 part union		2 27		26' 3/4" copper tubing @ .37	9 62
	1 hr. trucking @ .75		75		1 3/4" C corp cock	4 64
			35 13		1 3/4" C curb cock	6 03
					1 box & rod	5 00
					1 1/2 straight tail piece	50
					1 1/2 offset tail piece	50
					1/2 hr. town shovel 6.50	3 25
						37 13

Bill sent 1-5-59 13/

DATE _____

TOWN OF LEXINGTON — BOARD OF PUBLIC WORKS
WATER DIVISION

Sketch of Service Here

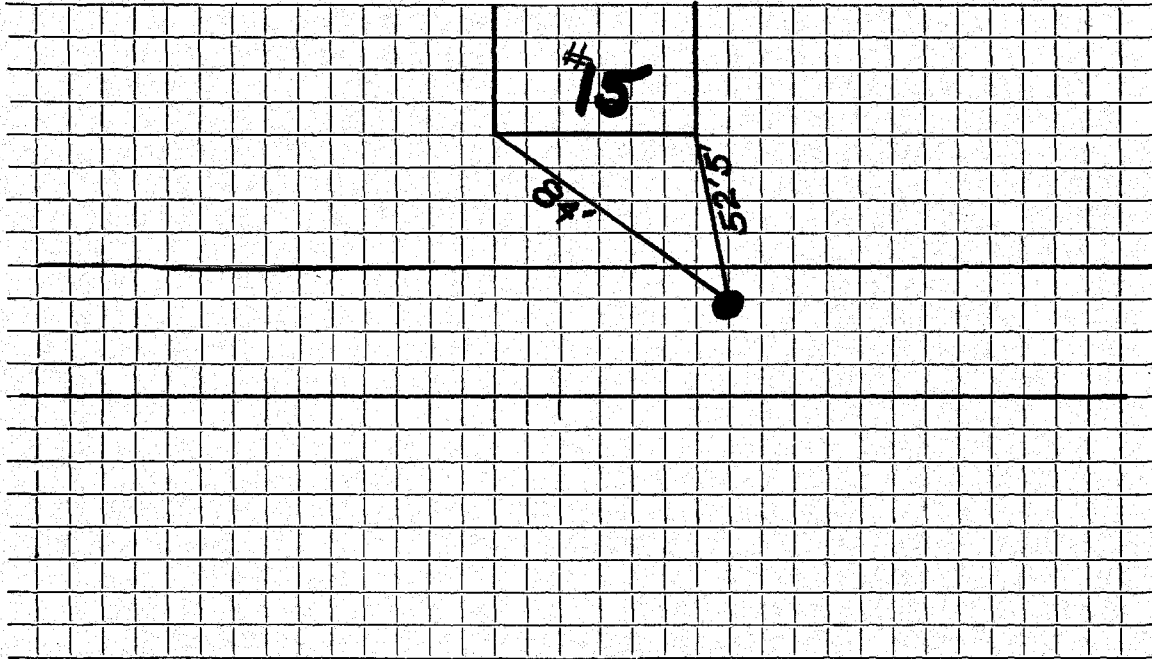

Connection made in Street. Work completed

Remarks:

.....

.....