

Name Edwin H. Nelson

Service No. ~~101~~ 2362

Address 34 Marlboro Road, Waltham, Mass.

7168

18 Richard Rd.

Location

18 Richard Road

Kind of Pipe

Size

Size of Main

Repair—Renewal—New Service

Location

Date
1941

Material

Amount

Total

Date

Amount

Dec. 23

2 hrs. @ 60¢

1 20

Dec. 11 1941

deposited

18.00

Com 17/19/41

10% Overhead

12

1 32

Dec 30, 1941

refund

✓ 26

43' 3/4" Copper tubing @ 19¢

8 17

1 3/4" C.x 1/2" I.S. & W.

2 50

1 hr. trucking

75

12 74

12 74

Refund of \$5.26 is to be credited to Sewer service #32.

Labor

DATE Dec 1 1911

TOWN OF LEXINGTON—BOARD OF PUBLIC WORKS

WATER DIVISION

The undersigned applies for a supply of water at No. 18 Richard St. and hereby agrees to comply with the rules and regulations as now, or at any future time, established by the Board of Selectmen.

Am't. of Estimate \$ 16⁰⁰

Am't. Paid \$ _____

Builder _____

Deposit by
30 Marlboro Rd
Matthew Mess


Owner

Address

Mary A. Hamilton
18 Richard Rd

Belleve Belmont

Sketch of Service Here

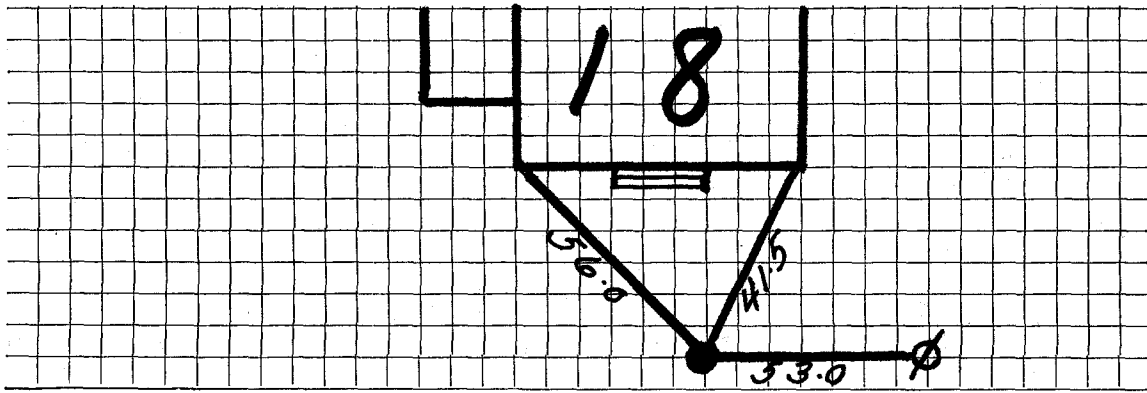

Connection made in _____ Street.

Work completed _____ 19

Remarks: