

Name Anthony Ruggiero

Service No.

255

Address 19 Richard Road

Lexington, Mass.

Location 19 Richard Road

Kind of Pipe

Size

Size of Main

~~REPAIR WORK~~ New Service

Location

Date	Material	Amount	Total	Date	Location	Amount
Nov. 13, '48	Labor	1 25	1 25	Oct 22 '48	Repaired	15 00
	10% Overhead		13			
	37' - 3/4" Copper Tubing @	255 9 1/4			Non-Charge	
	1 - 3/4" C x 1/2" I.W.H. S&W	3 15		Nov. 13, '48	Labor	1 25
	Trucking 1 hr. @.75	75		29' - 3/4" Copper Tubing @.255		7 40
			14 72	1 - 3/4" C Corp-cock		3 00
				1 - 3/4" C x 3/4" C urb-cock		3 68
				1 - Box & Rod		3 55
	trench dug by owner.			Littlefield Shovel 2 hrs. @ 7.00		14 00
				1 - 1/2" Straight Tail Piece		30
				1 - 1/2" Offset Tail Piece		30
				Trucking 1 hr. @.75		75
	Labor					34 23

DATE _____

TOWN OF LEXINGTON - BOARD OF PUBLIC WORKS

WATER DIVISION

The undersigned applies for a supply of water at No..... St. and hereby agrees to comply with the rules and regulations as now, or at any future time, established by the Board of Selectmen.

Am't of Estimate \$.....

Owner


Am't Paid \$.....

Address

Builder

.....

Sketch of Service Here

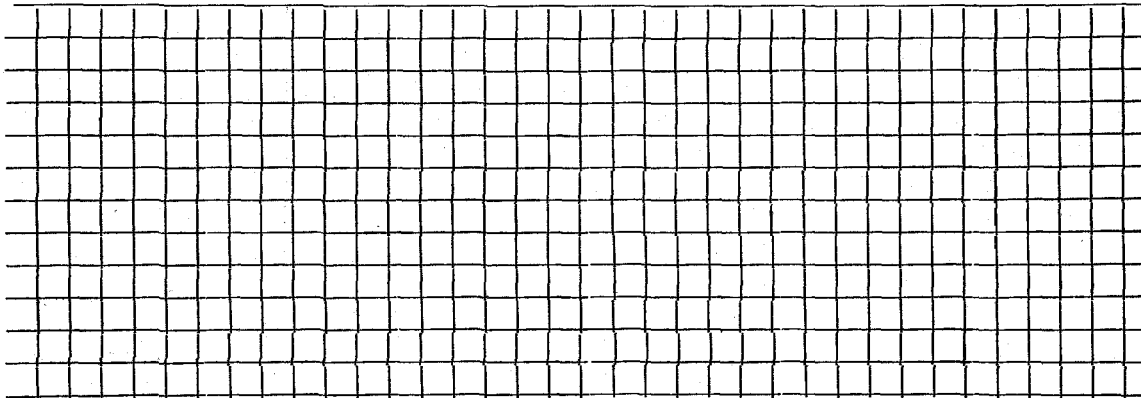

Connection made in Street.

Work completed19

Remarks:
