

Name Merle Miller

Service No. ~~78~~ 2303

Address 194 Mt. Vernon St., Malden

#1784

20 Richard Rd.

Location 20 Richard Rd.,

Kind of Pipe

Size

Size of Main

Repair—Renewal—New Service

Location

Date	Material	Amount	Total	Date	Amount
Oct. 22, 1940	4 hrs. @ 60¢	2 40		October 18, 1940 Deposited	20 00
<i>Jan 17-31-40</i>	10% Overhead	<u>24</u>	2 64	Dec 31, 1940 Refund -	3 34
	53' 3/4" Copper tubing @ 19¢		10 07		16 46
	1 3/4" C.S.& W.		2 25		
	2 hr. trucking @ 75¢		1 50		
	(Trench repairs on sewer)		- --		
			<u>16 46</u>		
	Labor				

Hadley Press, Inc., Lexington

DATE _____

TOWN OF LEXINGTON—BOARD OF PUBLIC WORKS

WATER DIVISION

The undersigned applies for a supply of water at No. ⁽²⁰⁾ 20 Richards Rd St. and hereby agrees to comply with the rules and regulations as now, or at any future time, established by the Board of Selectmen.

Am't. of Estimate \$ 20⁰⁰

Owner


Merton Johnson

Am't. Paid \$ _____

Address

Builder Merle Miller 194 Mt Vernon St Malden

Sketch of Service Here

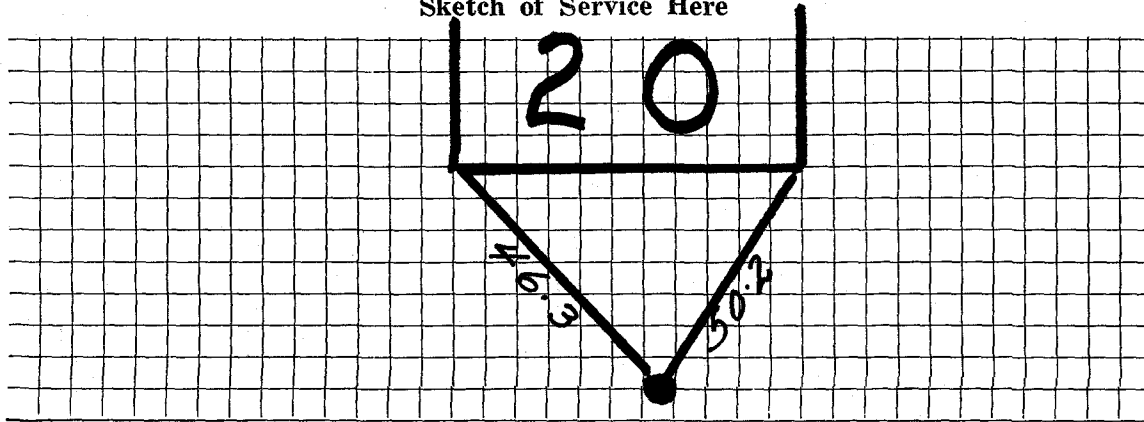

Connection made in _____ Street.

Work completed _____ 19

Remarks: