

Name **Albert Brun**Service No. <sup>139</sup> **3384**Address **21 Richard Road**Location **21 Richard Road**

Kind of Pipe

Size

Size of Main

~~REPAIR~~ **New Service***Em 12-1-47*

Location

Date	Material	Amount	Total	Date	Amount
Oct. 17, '47	Labor	1 05	1 05	Oct 9 '47	15 00
	10% Overhead		11	Dec. 31 '47	4 36
	55' - 3/4" Copper Tubing @.26	14 30			19 36
	1 - 3/4" C x 1/2" I.W.H. S & W	3 15			Non-Charge
	Trucking 1 hr. @.75		75	Oct. 17, '47	1 05
5-12-64	Repair		19 36	23' - 3/4" Copper Tubing @.26	5 98
	18' 3/4" Copper			1 - 3/4" C Corp-cock	3 00
	1 3/4" - 3 Part Union			1 - 3/4" C x 3/4" C Curb-cock	3 68
				1 - Box & Rod	4 26
				1 - 1/2" Straight Tail Piece	30
				1 - 1/2" Offset Tail Piece	30
				Trucking 1 hr. @.75	75
					<u>19 32</u>
	Labor				

DATE \_\_\_\_\_

TOWN OF LEXINGTON – BOARD OF PUBLIC WORKS  
**WATER DIVISION**

The undersigned applies for a supply of water at No..... St. and hereby agrees to comply with the rules and regulations as now, or at any future time, established by the Board of Selectmen.

Am't of Estimate \$.....

Owner .....


Am't Paid \$.....

Address .....

Builder .....

*127 Pulman St. Waketown Man*

Sketch of Service Here

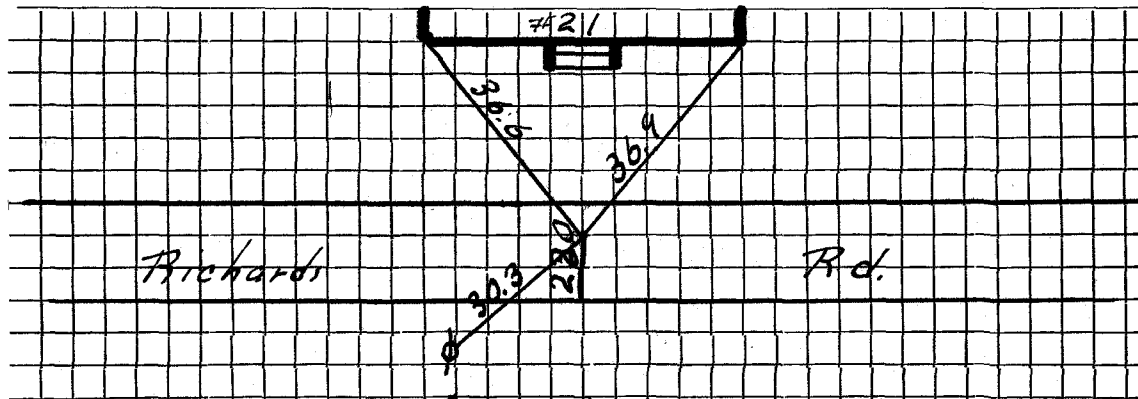

Connection made in ..... Street.

Work completed .....19

Remarks: