

Name Walter G. Black

Service No. # 2364

Address 11 Highland Avenue
22 Richard Rd.

Location 22 Richard Road

Kind of Pipe

Size

Size of Main

Repair—Renewal—New Service

Location

Date

Material

Amount

Total

Date

Amount

1/21/41

2 hrs. @ 60¢

1 20

10% Overhead

12

1 32

46' 3/4" Copper tubing @ 19¢

8 74

1 3/4" C.x 1/2" I S.& W.

2 25

1 hr. trucking @ 75¢

75

13 06

January 27, 1941 Deposited

13 06

Labor

DATE _____

TOWN OF LEXINGTON—BOARD OF PUBLIC WORKS

WATER DIVISION

The undersigned applies for a supply of water at No. _____ St. and hereby agrees to comply with the rules and regulations as now, or at any future time, established by the Board of Selectmen.

Am't. of Estimate \$ _____


Owner _____

Am't. Paid \$ _____

Address _____

Builder _____

Sketch of Service Here

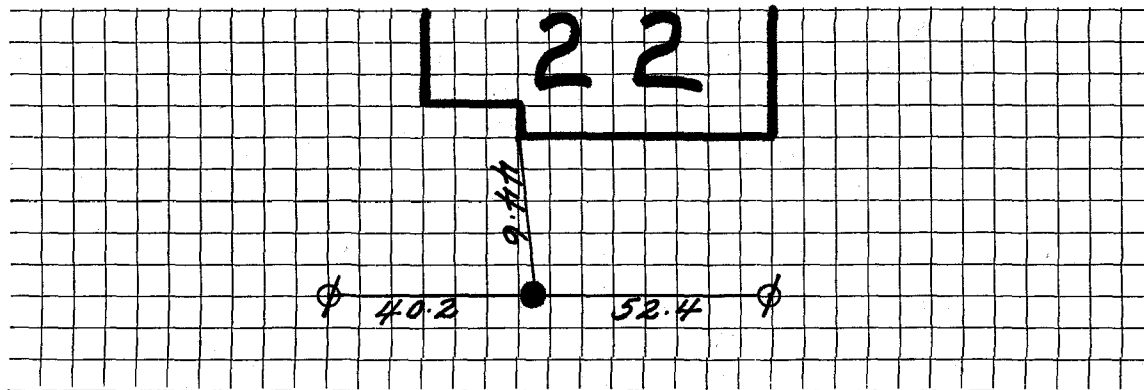

Connection made in _____ Street.

Work completed _____ 19

Remarks: