


DATE 10-18-01

TOWN OF LEXINGTON — BOARD OF PUBLIC WORKS

WATER DIVISION

Sketch of Service Here

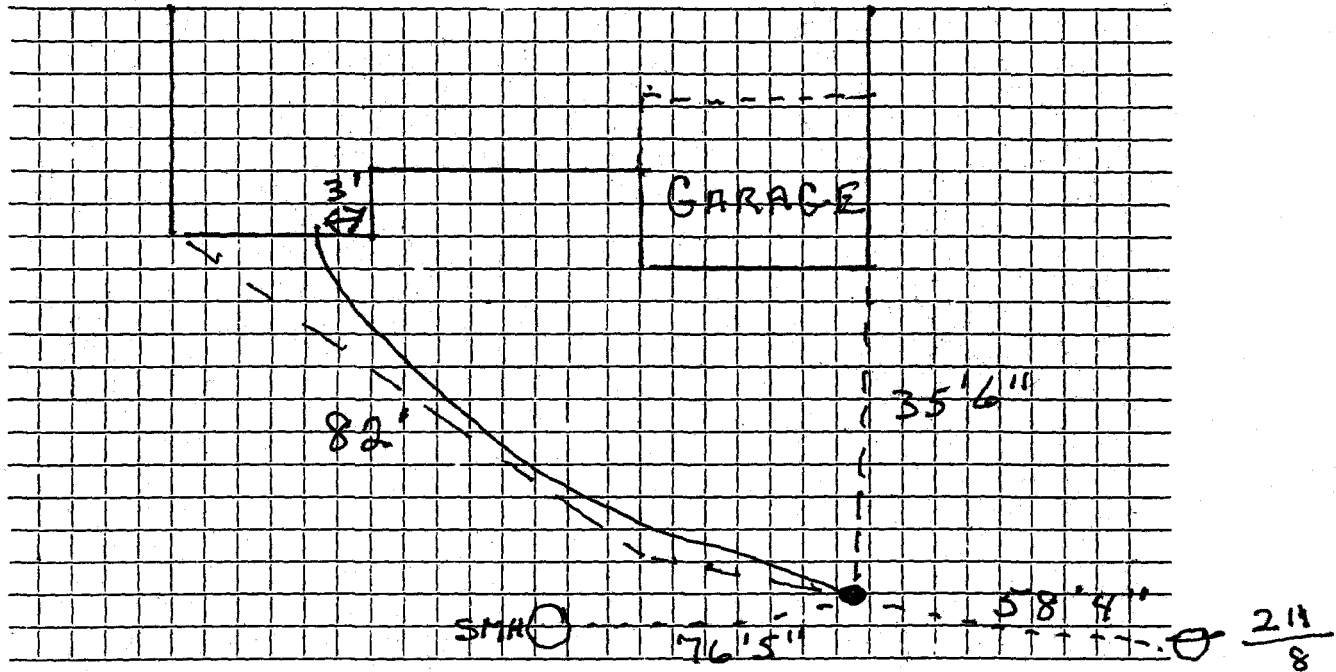

Connection made in RICHARDS... Rd..... Street. Work completed APRIL 17, 2001.....

Remarks: INSTALLED BY J. McLAUGHLIN.....