

Name Charles T. Abbott

Service No. ~~20~~ 2366

Address 75 Mishawum Road, Woburn, Mass.

3658, 3659

26 Richard Rd.

Location 26 Richard road.

Kind of Pipe

Size

Size of Main

~~Repair-Renewal~~ - New Service

Location

Date 1941	Material	Amount	Total	Date	Amount
Apr. 29	5 hrs. @ 60¢	3 00		4-28-41	28 00
Form 4/9/41	10% Overhead	30	3 30	June 11, 1941	6 66
	1' 3/4" C x 1/2" I.S. & W.		2 25		21 34
	66' 3/4" Copper tubing @ 19¢		12 54		
	1 3/4" C. x 3/4" C. Union (3 part)		1 00		
	Truck ing- 3 hrs. @ 75¢		2 25		
			21 34		
	Labor				

Hadley Press, Inc., Lexington

DATE Apr 25, 1941

TOWN OF LEXINGTON—BOARD OF PUBLIC WORKS

WATER DIVISION

The undersigned applies for a supply of water at No. 26 Richard Rd St. and hereby agrees to comply with the rules and regulations as now, or at any future time, established by the Board of Selectmen.

Am't. of Estimate \$ 28.00


Owner _____

Am't. Paid \$ _____

Address _____

Builder _____

Sketch of Service Here

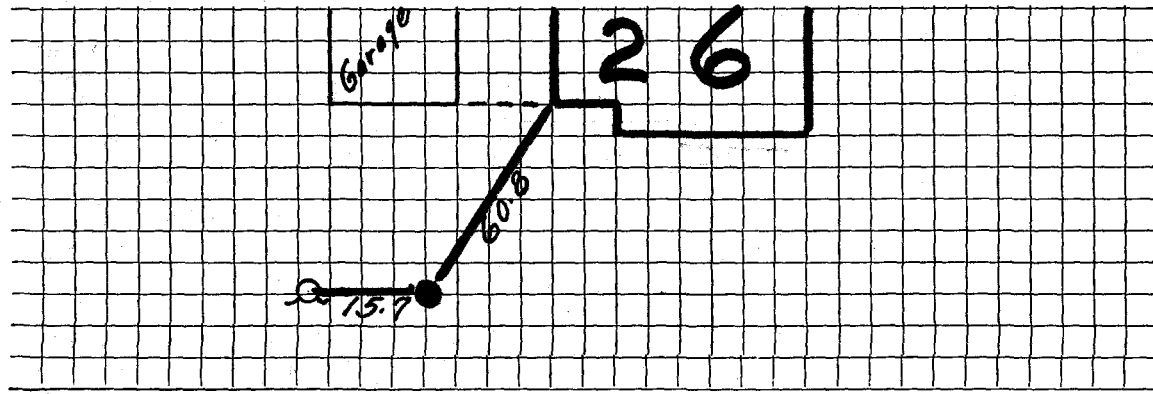

Connection made in _____ Street.

Work completed _____ 19

Remarks: