

Name Lawrence Aulenback

Service No. 71

#6102
#6103

Address 28 Richard Road

Lexington, Mass.

Location 28 Richard Road

Kind of Pipe

Size

Size of Main

~~XXXXXXXXXX~~ - New Service

Com. 5-29-50

Location

Date	Material	Amount	Total	Date	Amount
May 9, '50	Labor	1 30	1 30	April 27 '50	30 00
	10% Overhead		13	June 8 '50	2 88
	55' - 3/4" Copper Tubing @.23		12 65		21 12
	1 - 3/4" C x 1/2" I.W.H. S&W		3 29		No Charge
	Trucking 1 hr. @.75		75	May 9, '50	Labor
	Patching 3 x 3		3 00		10' - 3/4" Copper Tubing @.23
			21 12		1 - 3/4" C Corp-cock
					1 - 3/4" C x 3/4" C Curb-cock
					1 - Box & Rod
					1 - 1/2" Straight Tail Piece
					1 - 1/2" Offset Tail Piece
					Littlefield Shovel 1 hr. @ 7.00
					Trucking 1 hr. @.75
	Labor				75
					23 71

DATE _____

TOWN OF LEXINGTON - BOARD OF PUBLIC WORKS

WATER DIVISION

The undersigned applies for a supply of water at No..... St. and hereby agrees to comply with the rules and regulations as now, or at any future time, established by the Board of Selectmen.

Am't of Estimate \$.....

Owner


Am't Paid \$.....

Address

Builder

.....

Sketch of Service Here

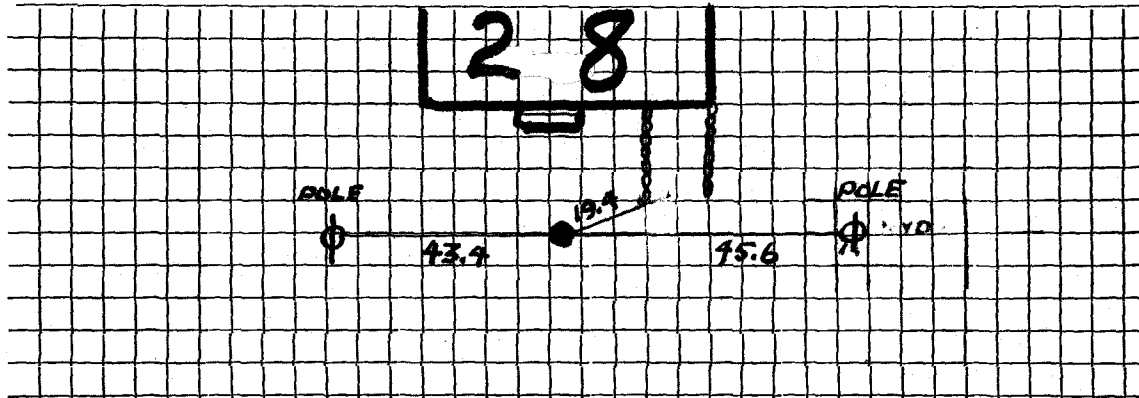

Connection made in Street.

Work completed19

Remarks: