

Name Mr. James R. Smith

Service No.

3

Address 154 Highland Ave. Arlington

3 Richards Rd.

#3 Richards Rd

Location Lot #43, ~~Power~~ St.

Kind of Pipe

Size

# 2 1/2 Size of Main

~~Repair-Renewal~~ - New Service

Location

Date	Material	Amount	Total	Date	Location	Amount
Comm. 26.25 6/21/32	22' 1" C.L. Pipe @.27	5 94				
	1 1" L.L. Coup.	17				
	2 1" L.L. Ells @.25	50				
	1 1" Br. Nipple	15				
	1 S & W	3 00				
	Trucking	75	10 51			
3/11/32	7 Hrs. Labor @.60	4 20				
	3 " " @.55	1 65	5 85			
	15% Overhead		65			
	<b>COST</b>		17 14			
	<b>CHARGE</b> 22' @ .75	16 50	16 50			
	labor Compressor, break-					
	ing frost, 3 Hrs. @ 3.25		9 75			
			26 25			

Sept. 14 1932 - Cash

26 25

Hadley Press, Inc. Lexington

1-2-3 - above cellar floor

DATE March 3, 1932

# TOWN OF LEXINGTON - BOARD OF PUBLIC WORKS

## WATER DIVISION


The undersigned applies for a supply of water at No. Lot # 43, Tower St. and hereby agrees to comply with the rules and regulations as now, or at any future time, established by the Board of Selectmen.

Am't. of Estimate \$ \_\_\_\_\_

Am't. Paid \$ \_\_\_\_\_

Builder \_\_\_\_\_

Owner James V. Smith  
Address 154 Highland Ave.  
Arlington Mass

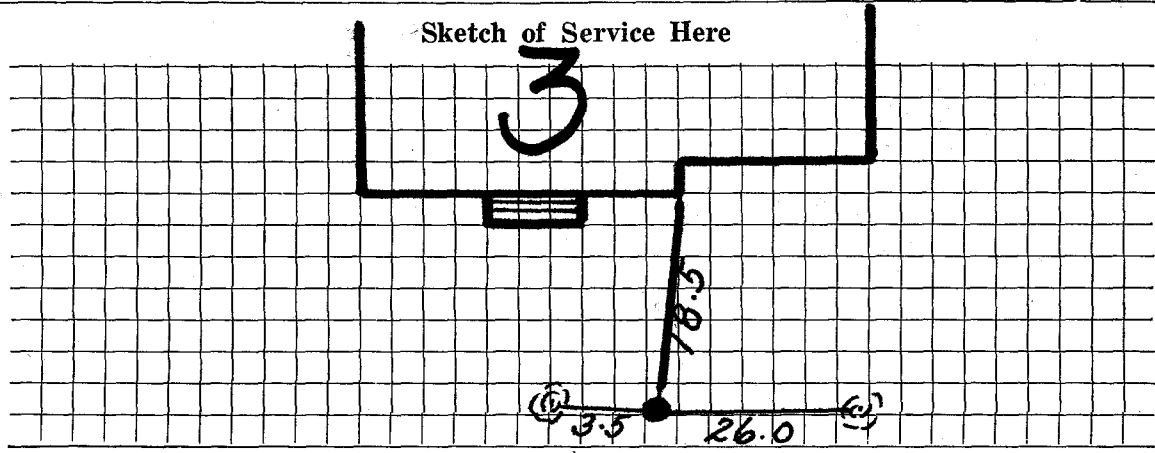

Connection made in \_\_\_\_\_ Street. Work completed \_\_\_\_\_ 19

Remarks: