

Name Philip DeAngelis

Service No. 149

Address 30 Richard Road

4453

Lexington, Mass.

Location 30 Richard Road

Kind of Pipe

Size

Size of Main

~~Repair~~ ~~Renewal~~ - New Service

Com. 9-5-50

Location

Date

Material

Amount

Total

Date

Amount

Jul. 12, '50

Labor

2 45

2 45

June 28 '50

Deposited

60 00

10% Overhead

25

45' - 3/4" Copper Tubing @.23

10 35

No Charge

41 09

1 - 3/4" C x 1/2" I.W.H. S&W

3 29

Jul. 12, '50

Labor

2 45

Littlefield Shovel 3 hrs. @7.00

21 00

10' - 3/4" Copper Tubing @.23

2 30

Trucking 1 hr. @.75

.75

1 - 3/4" C Corp-cock

3 15

Patching 3 x 3

3 00

1 - 3/4" C x 3/4" C Curb-cock

3 85

41 09

1 - Box & Rod

3 35

1 - 1/2" Offset Tail Piece

38

1 - 1/2" Straight Tail Piece

38

Littlefield Shovel 1 hr. @ 7.00

7 00

Trucking 1 hr. @.75

75

Labor

23 61

DATE _____

TOWN OF LEXINGTON—BOARD OF PUBLIC WORKS

WATER DIVISION

The undersigned applies for a supply of water at No. _____ St. and hereby agrees to comply with the rules and regulations as now, or at any future time, established by the Board of Selectmen.

Am't. of Estimate \$ _____

Owner _____


Am't. Paid \$ _____

Address _____

Builder _____

Sketch of Service Here

30

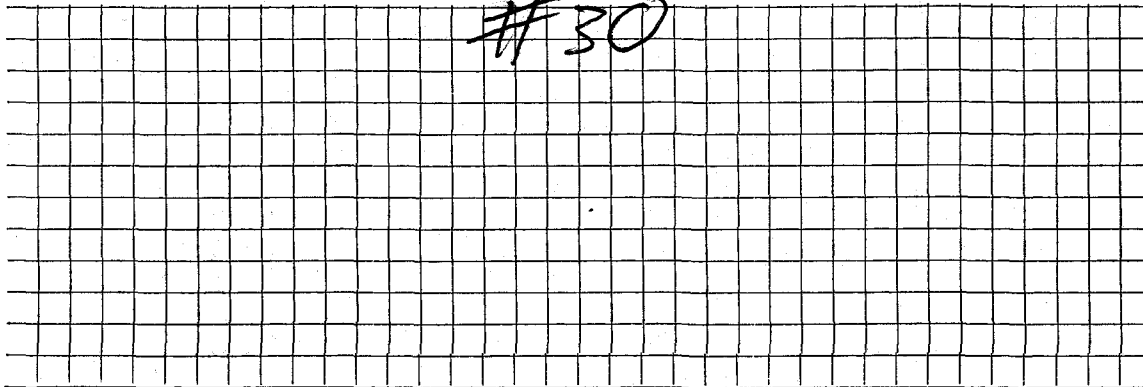

Connection made in _____ Street.

Work completed _____ 19

Remarks: