

Name James R. Smith

Service No. 2358

Address Lot #41, Richards Road
7 Richard Rd.

(154 Highland Ave., Arl.)

Location #7 Richard Rd #2074-2075

Kind of Pipe

Size

Size of Main

~~Repair - Renewal~~ - New Service

Location

Date	Material	Amount	Total	Date	Amount
10/25/35	3 hrs. labor @ 60¢	1 80		Oct 25 35	# 14 30
	10% Ovhd. on labor	18		Dec. 31, 1935	2 72
	33' 3/4" Copper pipe @ 20¢	6 60			# 11 58
	1 S. & W.	2 00			
	Trucking	1 00			
			\$11.58		
	Labor				

Hedley Press, Inc., Lexington

DATE Oct 23, 1935

TOWN OF LEXINGTON—BOARD OF PUBLIC WORKS

WATER DIVISION

The undersigned applies for a supply of water at No. Lot #41 Richard Rd. and hereby agrees to comply with the rules and regulations as now, or at any future time, established by the Board of Selectmen.


Am't. of Estimate \$ ^{14.30} 14.30

Am't. Paid \$ _____

Builder _____

Owner James Smith
Address 154 Highland Ave.
Lexington Mass

82
45
450
128
14.30
20.00

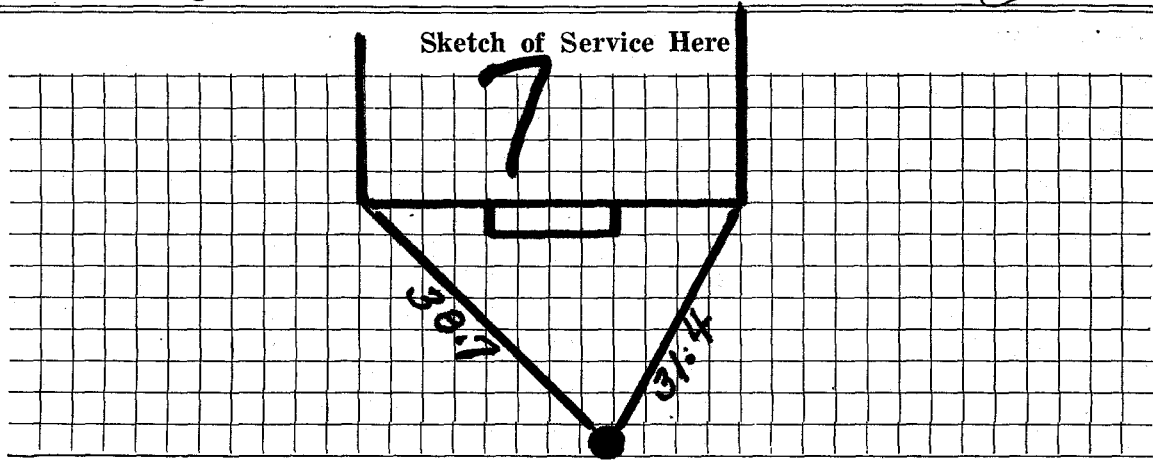

Connection made in _____ Street. Work completed _____ 19

Remarks: