

Name Norfolk Land Trust

Service No. 252359

Address 449 East Street, Dedham, Mass.

Builder--H. H. Schwartz  
#9 Richard Rd.

Location 9 Richard

Kind of Pipe

Size

Size of Main

Repair—Renewal—New Service

Location

Date	Material	Amount	Total	Date	Amount
1939					
Sept.	2 hrs. @ 60¢	1 20		July 21, 1939	17 00
<i>Cont. 10/20/39</i>	10% Overhead	12	1 32	<i>Deposited</i>	
	34' 3/4" Copper tubing @ 15¢		5 10		
	1 3/4" C.x 1/2" I S. & W.		2 10		
	2 hrs. trucking @ 75¢		1 50		
			<u>10 02</u>		
	Charge: Flat Rate 34' @ 50¢		\$17.00		
	Labor				

Hadley Press, Inc., Lexington

w. 17.  
s. 50

DATE July 20, 1939

# TOWN OF LEXINGTON—BOARD OF PUBLIC WORKS

## WATER DIVISION

The undersigned applies for a supply of water at No. 9 Richard Road St. and hereby agrees to comply with the rules and regulations as now, or at any future time, established by the Board of Selectmen.

Am't. of Estimate \$ 17.00

Owner Norfolk Land Trust


Am't. Paid \$ \_\_\_\_\_

Address 449 East St. Dedham

Builder H. H. Schwartz

Mass.

Sketch of Service Here

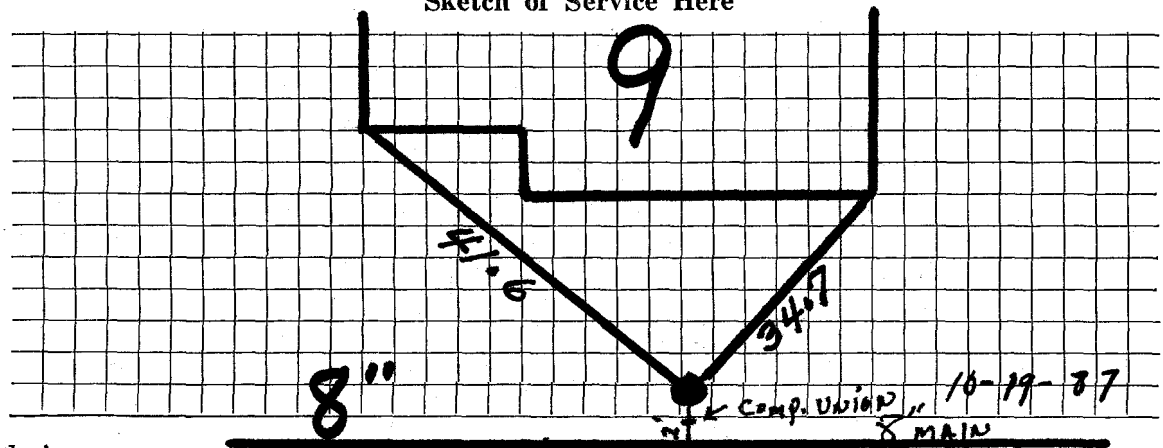

Connection made in \_\_\_\_\_ Street. Work completed \_\_\_\_\_ 19

Remarks: