




DATE \_\_\_\_\_

TOWN OF LEXINGTON — BOARD OF PUBLIC WORKS  
**WATER DIVISION**

Sketch of Service Here

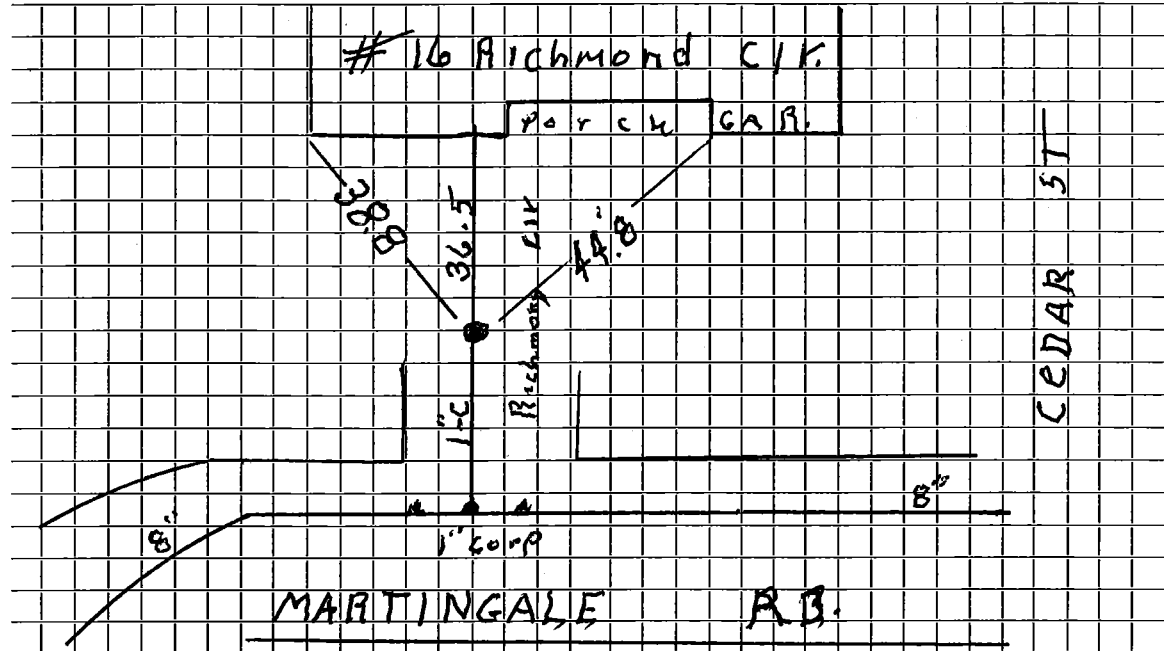

Connection made in MARTINGALE R.B. Street. Work completed .....

Remarks: .....

.....

.....