


TOWN OF LEXINGTON — BOARD OF PUBLIC WORKS

WATER DIVISION

Sketch of Service Here

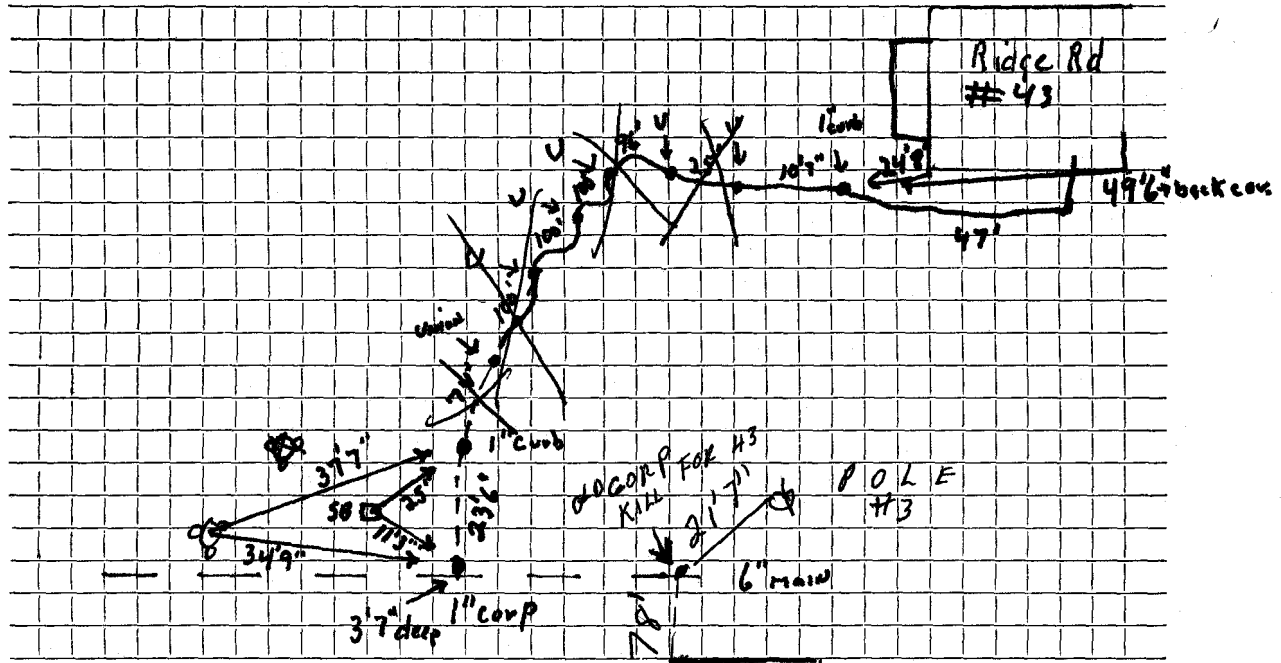

Connection made in Ridge Rd Street. Work completed

Remarks: 23'6"-1" copper outside - 552' 1" inside

Service CHANGED TO NEW MAIN