

#1995

WATER SERVICE RECORD

Name Michael Graziano

Service No. 10

Address 44 Ridge Road

Location

~~Revised~~ New Service W.O. #7818

Comm 5-27-63


| Date    | Material                         | Amount | Total | Date    | Material                | Amount |
|---------|----------------------------------|--------|-------|---------|-------------------------|--------|
| 4-12-63 | Labor                            | 25.74  |       | 4-4-63  | Deposit                 | 150.00 |
|         | 10% O.H.                         | 2.57   | 28.31 | 5-27-63 | Refund                  | 66.03  |
| 74'     | 3/4" Copper tubing @.42          |        | 31.08 |         |                         | 83.97  |
| 1       | 3/4" C x 1/2 I.W.H. Stop & Waste |        | 6.17  |         | NON CHARGE              |        |
| 1       | 3/4" C 3 part union              |        | 2.41  | 4-12-63 | Labor                   | 8.70   |
| 1       | hr. Trucking @3.00               |        | 3.00  | 25'     | 3/4" Copper tubing @.42 | 10.50  |
| 2       | hrs. Town Shovel @6.50           |        | 13.00 | 1       | 3/4" C Corp Cock        | 4.91   |
|         |                                  |        | 83.97 | 1       | 3/4" C Curb Cock        | 6.28   |
|         |                                  |        |       | 1       | Box & Rod               | 4.90   |
|         |                                  |        |       | 1       | 1/2 Straight tailpiece  | .50    |
|         |                                  |        |       | 1       | 1/2 Offset tailpiece    | .50    |
|         |                                  |        |       | 1       | hr. Trucking @3.00      | 3.00   |
|         |                                  |        |       | 1       | hr. Town Shovel @6.50   | 6.50   |
|         |                                  |        |       |         |                         | 45.79  |

DATE \_\_\_\_\_

TOWN OF LEXINGTON — BOARD OF PUBLIC WORKS

**WATER DIVISION**

Sketch of Service Here

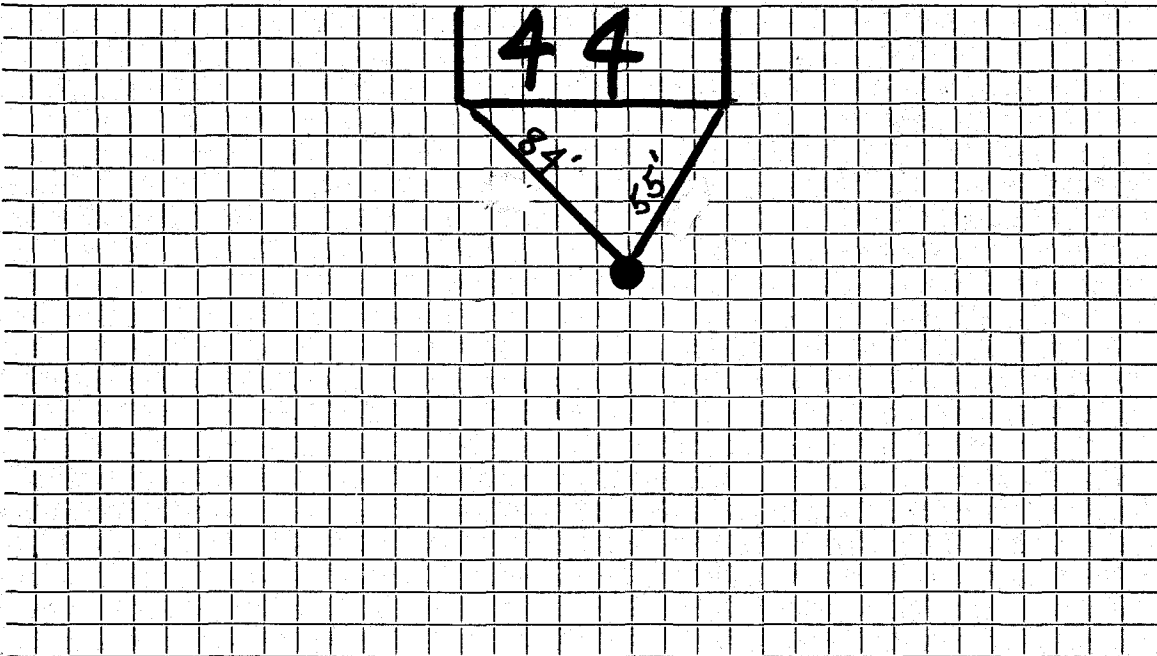

Connection made in ..... Street.      Work completed .....

Remarks: .....  
.....  
.....