


DATE _____

TOWN OF LEXINGTON — BOARD OF PUBLIC WORKS

WATER DIVISION

Sketch of Service Here

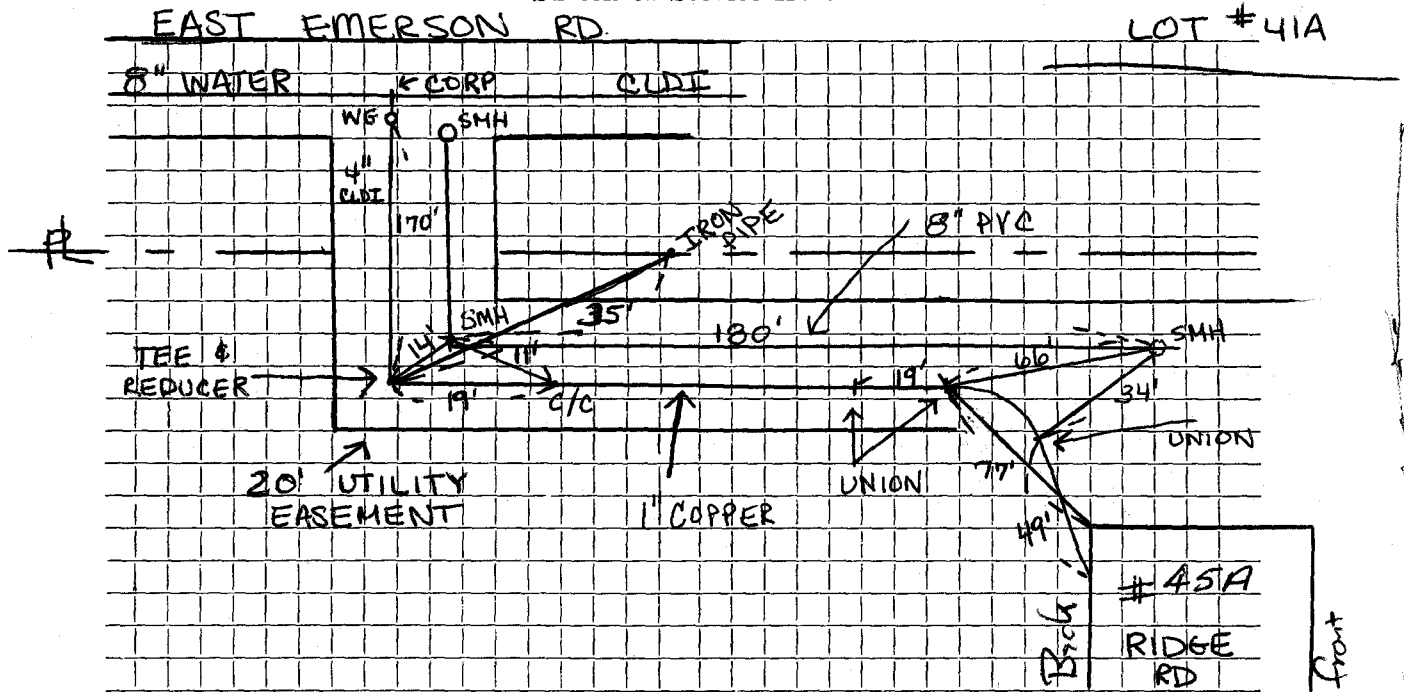

Ridge Rd →

Connection made in EAST EMERSON Street. Work completed


Remarks: EASEMENT OFF OF EAST EMERSON

← Lincoln →

TOWN OF LEXINGTON — BOARD OF PUBLIC WORKS

WATER DIVISION

Sketch of Service Here

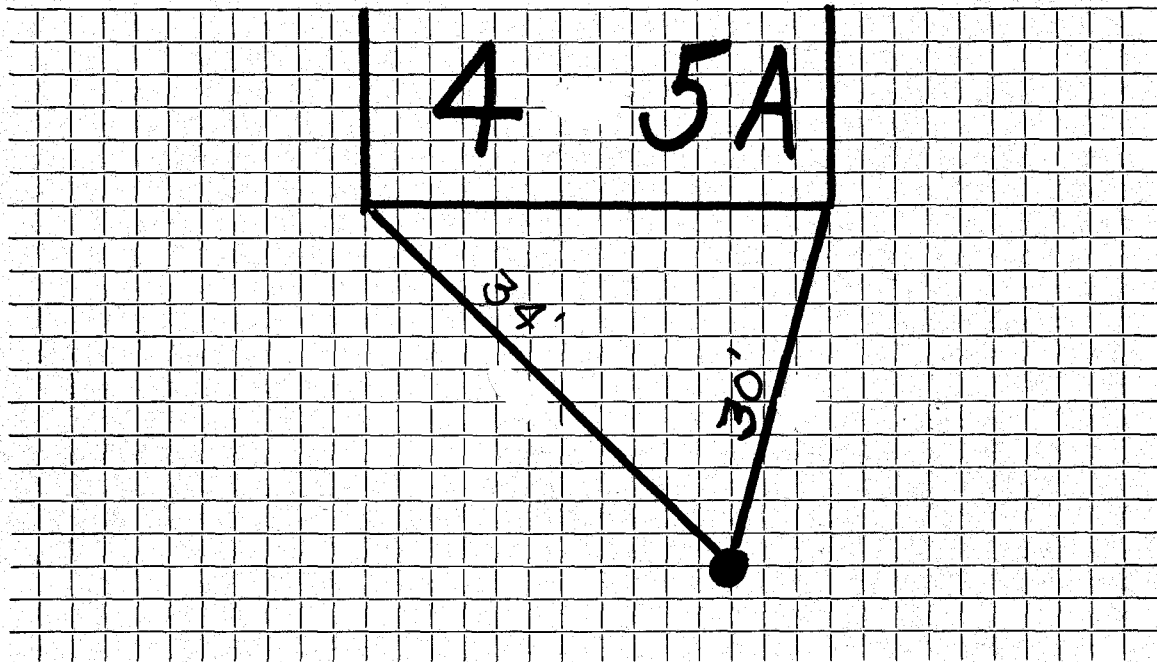

Connection made in Street. Work completed

Remarks:

.....

.....