

WATER SERVICE RECORD

Name John L. Meurer

Service No. 132

Address 46 Bridge Road

1793

Location Lexington

Repair/General - New Service


Com. 9-29-52

Date	Material	Amount	Total	Date	Amount	
8/11/52	Labor	5 10		7-9-52 Deposited	30 00	
	10% Overhead	51	5 61		<u>NON CHARGE</u>	
	55' - 3/4" Copper tubing @ .34	18 70	5 94	8/11/52	Labor	5 11
	1 - 3/4" C x 1/2" I.W.H. stop & waste	5 94			25' - 3/4" Copper tubing @ .34	8 50
	3 hrs. Littlefield shovel	21 00			1 - 3/4" Corp-cock	4 33
	1 hr. trucking	75			1 - 3/4" C x 3/4" C. Curb-cock	4 67
			50 00		1 - 3/4" C x 3/4" C. Union 3 pts.	1 72
4/1/99	60' 1" COPPER				1 - 1/2" straight tail piece	50
	1 3/4 x 1" Comp Union				1 - 1/2" offset tail piece	50
					2 hrs. Littlefield shovel	14 00
					1 hr. trucking	75
						<u>40 08</u>

TOWN OF LEXINGTON — BOARD OF PUBLIC WORKS

WATER DIVISION

Sketch of Service Here

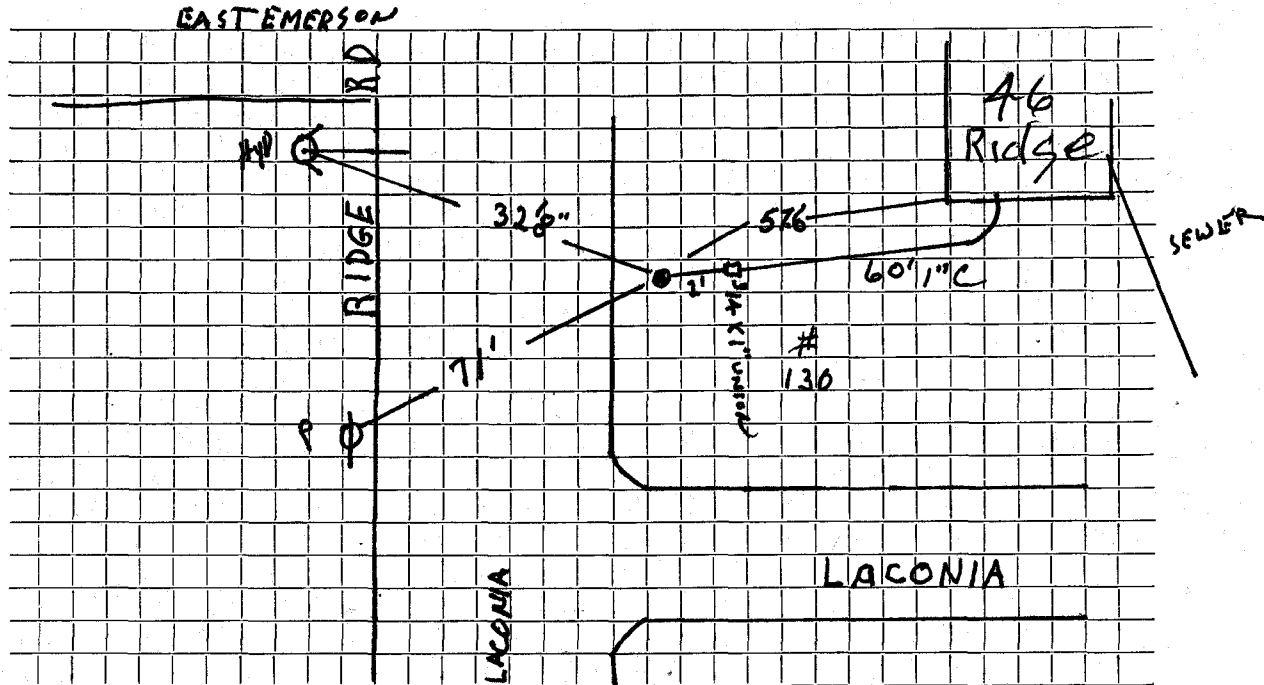

Connection made in RIDGE RD Street. Work completed

Remarks:

.....

.....