

WATER SERVICE RECORD

2391  
Service No. 209

Name Leo Enrico

Address # 12 BINGE AVE.

Location

~~Equipment~~ - New Service


WO# 7009

Comm 2-26-62

Date	Material	Amount	Total	Date		Amount
12/20/61	Labor	4 19		12-18-61	Deposit	50 00
	10% O.H.	42	4 61	2-26-62	Refund	16 68
	42' 3/4" Copper Tubing @ .42		17 64			33 32
	1 3/4" Cx 1/2 IWH Stop & Waste		6 17			
	1 Bow & Rod		4 90		1 1/2 Straight Tailpiece	50
			33 32		1 1/2 Offset Tailpiece	50
						1 00

TOWN OF LEXINGTON — BOARD OF PUBLIC WORKS

WATER DIVISION

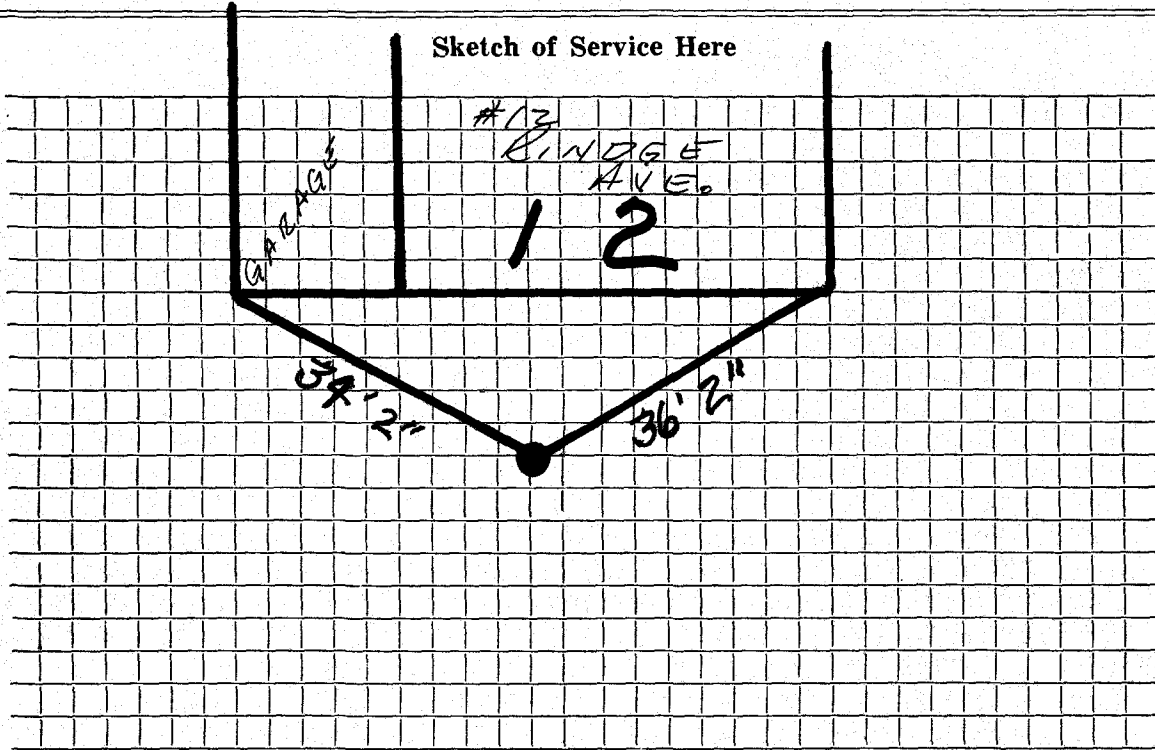

Connection made in ..... Street. Work completed .....

Remarks: .....

.....

.....