

WATER SERVICE RECORD

Name **Leo Enrico**

Service No. **210**

Address **14 Rindge Avenue**

Location

~~Repair - BROOKLYN~~ **New Service**

WO # **7010**


Comm **3-26-62**

Date	Material	Amount	Total	Date	Amount
12/20/61	Labor	4 19		12-18-61	Deposit 50 00
	10% O.H.	42	4 61	2-26-62	Refund 23 43
40'	3/4" Copper Tubing @ .42		16 80		27 58
	1 3/4" Cx 1/2 I.W.H. Stop & Waste		6 17		
			27 58	12/20/61	Labor 2 15
					24' 3/4" Copper Tubing @ .42 10 08
					1 3/4" C Curb Cock 6 28
					1 3/4" C Curb Cock 4 91
					1 Bow & Rod 4 90
					1 1/2 Straight Tailpiece 50
					1 1/2 Offset Tailpiece 50
					29 32

DATE _____

TOWN OF LEXINGTON — BOARD OF PUBLIC WORKS
WATER DIVISION

Sketch of Service Here

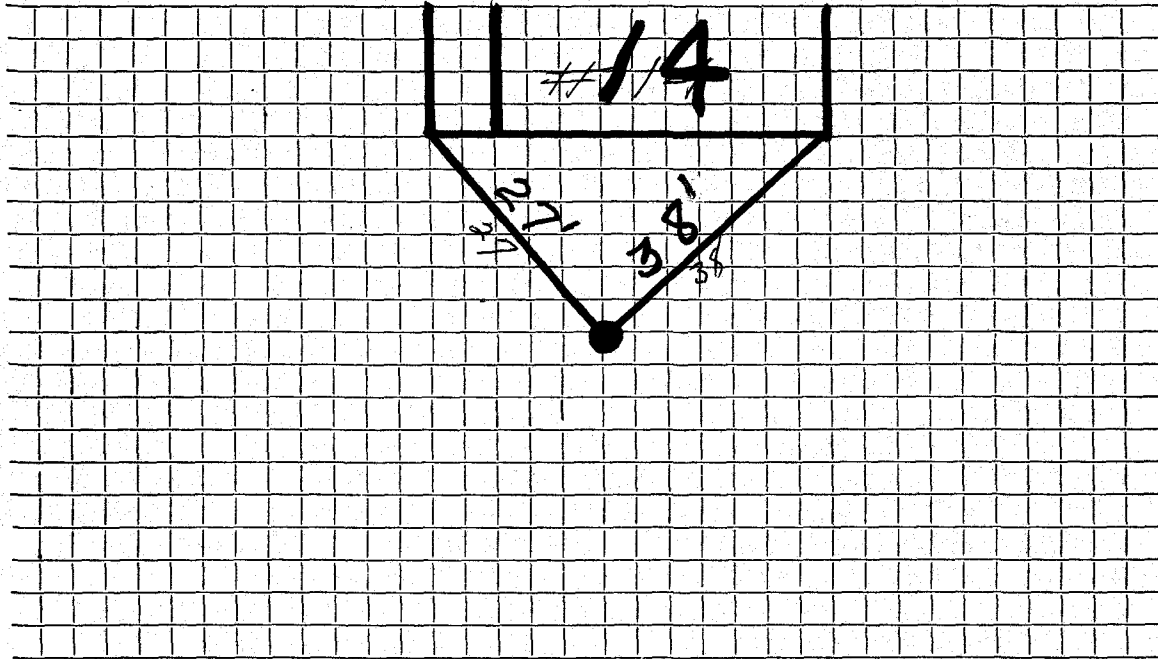

Connection made in Street. Work completed

Remarks:
.....
.....