

Name Arthur Vasseur
 Address 24 Rindge Avenue

Service No. 2371

117

#6415

Location 24 Rindge Ave.

Kind of Pipe Size Size of Main

~~Work~~—Renewal—~~NO SERVICE~~

Location Conn 8-22-60

Date	Material	Amount	Total	Date	Amount
7-15-60	Labor	2 05		6-8-60	25 00
	10% O.H.	<u>21</u>	2 26	5-17-41	9 78
57'	3/4" Copper tubing@.42		23 94		<u>34 78</u>
1	3/4" Cx 1/2 I.W.H. Stop & Waste		6 17		
1	3/4" C3 Part union		<u>2 41</u>		
			34 78	7-15-60	
					NON CHARGE
	Labor				1 75
	28' 3/4" Copper tubing@.42				11 76
	1 3/4" C Corp cock				4 91
	1 3/4" C Gurb cock				6 28
	1 Box & Rod				4 90
	1 1/2 Straight tailpiece				50
	1 1/2 Offset tailpiece				<u>50</u>
	Labor				30 60

Deposit
Paid

Bill sent 8-22-60 978

Hadley Press, Inc., Lexington

DATE _____

TOWN OF LEXINGTON—BOARD OF PUBLIC WORKS

WATER DIVISION

The undersigned applies for a supply of water at No. _____ St. and hereby agrees to comply with the rules and regulations as now, or at any future time, established by the Board of Selectmen.


Am't. of Estimate \$ _____

Owner Caroline Jackson

Am't. Paid \$ _____

Address 24 Fridge Ave.

Builder _____

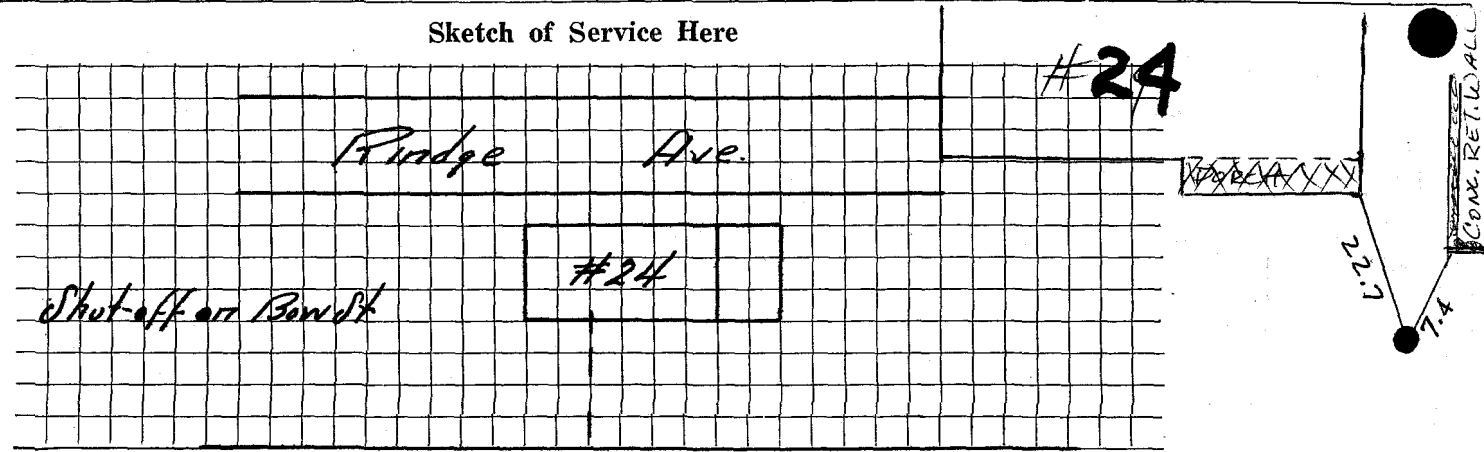

Connection made in Bow Street. 42.4 Work completed St. 19

Remarks:

