

Name Felix Costanza

Service No.

209

# 4788

Address 26 Rindge Avenue

Lexington, Mass.

Location 26 Rindge Avenue

Kind of Pipe

Size

Size of Main

~~RENEWAL~~ New Service

Location

Date	Material	Amount	Total	Date	Amount
Nov. 23, '48	Labor	6 25	6 25	Nov. 23, '48	30 00
	10% Overhead		63	Dec 31, '48	1 01
	27' - 3/4" Copper Tubing @ .255	6 89	6 89		28 99
	1 - 3/4" C x 1/2" I.W.H. S&W	3 15	3 15	Nov. 23, '48	Labor
	1 - 3/4" C x 3/4" C Union (3 pts)	1 32	1 32		28' - 3/4" Copper Tubing @ .255
	Littlefield Shovel 1 hr. @ .75	7 00	7 00		1 - 3/4" C Corp-cock
	Allis-Chalmers Tractor 1 hr.	3 00	3 00		1 - 3/4" x 3/4" C Curb-cock
	Trucking 1 hr. @ .75		75		1 - Box & Rod
			28 99		1 - 1/2" Offset Tail Piece
					1 - 1/2" Straight Tail Piece
					Trucking 1 hr. @ .75
				3-30-49	20 87
	Labor				60' 3/4" Copper
					1 3/8" C. Corp Cock
					1 3/4" C. X 3/4" C. - 3 Part Union

TOWN OF LEXINGTON - BOARD OF PUBLIC WORKS

**WATER DIVISION**

The undersigned applies for a supply of water at No..... St. and hereby agrees to comply with the rules and regulations as now, or at any future time, established by the Board of Selectmen.

Am't of Estimate \$.....

Owner .....


Am't Paid \$.....

Address .....

Builder .....

.....

Sketch of Service Here

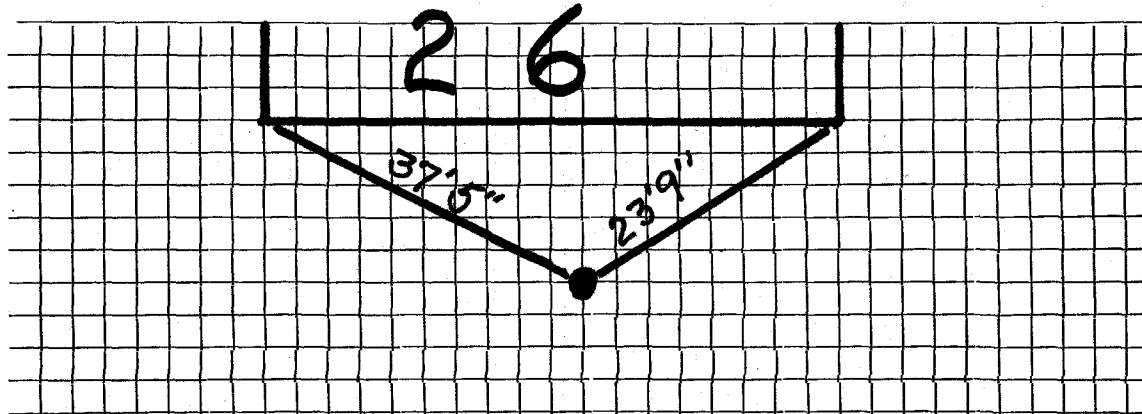

Connection made in ..... Street.

Work completed .....19

Remarks: