

WATER SERVICE RECORD

Name Frank Caprio Sr.

Service No. 109

Address 31 RINDGE AVE. (PIT METER) VACANT LOT

Location Lots 218-219 St 4750 LF

~~XXXXXXXXXX~~ New Service

W O # 9547

Comm 10-29-62


Date	Material	Amount	Total	Date	Amount	
8-17-62	Labor	28.68		8-17-62	Deposit	75.00
	10% O.H.	2.87	31.55	10-29-62	Re Sumd	8.96
10'	3/4" Copper tubing @.42		4.20			66.04
1	3/4" CX 1/2 I/W.H. Stop & Waste		6.17			
60	Brick		2.50		NON CHARGE	
1	Bag Cement		1.60	8-10-62	Labor	3.72
1	Pit Cover & Frame		11.50	10'	3/4" Copper tubing @.42	4.20
1	Hr. Trucking @3.00		3.00	1	3/4" C Corp Cok	4.91
1	Hr. Town Shovel @5.50		5.50	1	3/4" C Curb Cok	6.28
			66.04	1	Box & Rod	4.90
						24.01

DATE _____

TOWN OF LEXINGTON — BOARD OF PUBLIC WORKS

WATER DIVISION

Sketch of Service Here

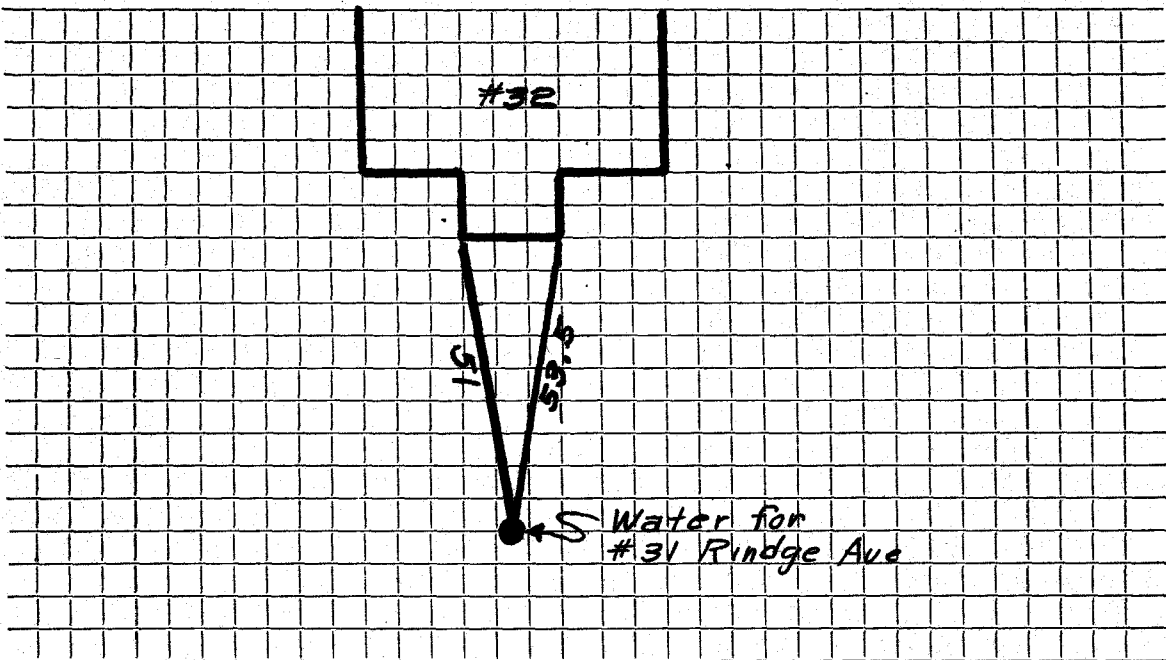

Connection made in Street. Work completed

Remarks:
.....
.....