

WATER SERVICE RECORD

1470
Service No.

188

Name Frank Caprio

Address 32 Ripdge Avenue

Location


~~Removal~~ New Service

Comm 11-28-60

Date	Material	Amount	Total	Date	Amount	
10-27-60	Labor	1.94		8-31-60	Deposit	35.00
	10% O.H.	.19	2.13	11-25-60	Refund	7.90
40'	3/4" Copper tubing @.42		16.80			25.10
1	3/4" C x 1/2 I.W.H. Stop & Waste		6.17		NON CHARGE	
			25.10	10-27-60	Labor	1.88
					25' 3/4" Copper tubing @.42	10.50
					1 3/4" C Corp Cock	4.91
					1 3/4" C Curb Cock	6.28
					1 Box & Rod	4.90
					1 1/2 Straight tailpiece	.50
					1 1/2 Offset tailpiece	.50
						29.47

TOWN OF LEXINGTON — BOARD OF PUBLIC WORKS
WATER DIVISION

Sketch of Service Here
Penta House 96

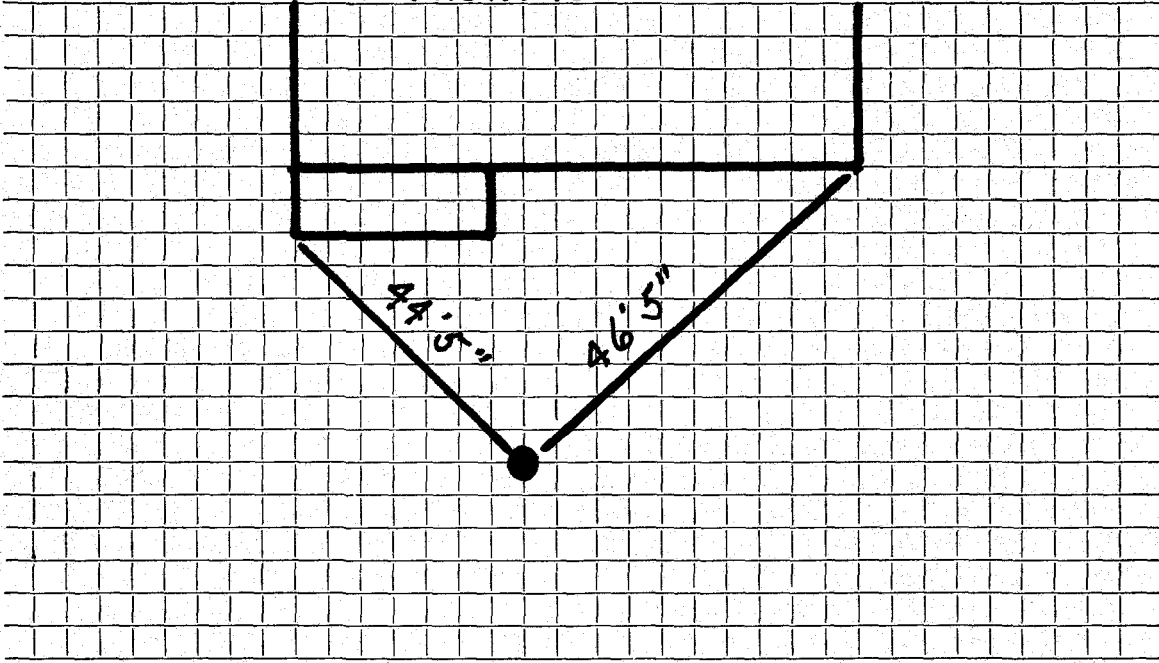

Connection made in Street. Work completed

Remarks:
.....
.....