

## WATER SERVICE RECORD

Name Thomas A. Sola

Service No. 312

Address 35 Rindge Ave.

Location

Repair ~~Renewal~~ New Service

Com 11-9-53


Date	Material	Amount	Total	Date	Amount
10/6/53	Labor	1 90		9-29-53 Deposited	25 00
	10% Overhead	19	2 09	11-9-53 Refunded	4 01
	39' - 3/4" Copper tubing @ .3629	14 15		NON CHARGE	20 99
	1 - 3/4" C x 1/2" I.W.H. stop & waste	4 00		10/6/53 Labor	1 90
	1 hr. trucking		75	11' - 3/4" Copper tubing @ .3629	3 99
			20 99	1 - 3/4" C. corp-cock	4 33
				1 - 3/4" C x 3/4" C. curb-cock	4 67
				1 box and rod	3 90
				1 - 1/2" straight tail piece	50
				1 - 1/2" offset tail piece	50
				1 hr. trucking	75
					20 54

DATE \_\_\_\_\_

TOWN OF LEXINGTON — BOARD OF PUBLIC WORKS

WATER DIVISION

Sketch of Service Here

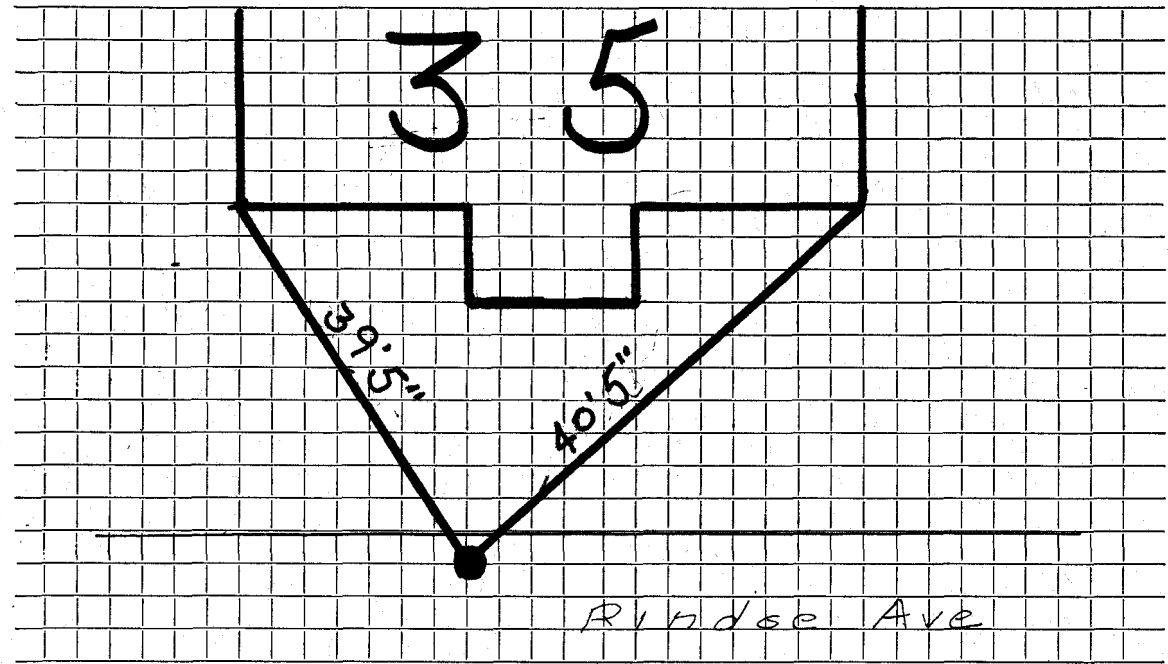

Connection made in ..... Street. Work completed .....

Remarks: .....  
.....  
.....