

WATER SERVICE RECORD

#3344

Name Thomas A. Sola

Service No. 19

Address 36 Rindge Ave.

Location

~~Repair~~ ~~XXXXXX~~ - New Service

Com. 3-21-55


Date	Material	Amount	Total	Date	Amount
2/28/55	Labor	1 85		2-21-55	Deposited 25 00
	10% overhead	19	2 04	3-21-55	Refunded (5 96
	35' - 3/4" copper tubing@.35	12 25			NON CHARGE 19 04
	1 - 3/4"C x 1/2 I.W.H. stop&waste	4 00		2/28/55	Labor 1 85
	1 hr. trucking		75		6' - 3/4" copper tubing@.35 2 10
			19 04		1 - 3/4"C. corp-cock 4 33
					1 - 3/4"C. curb-cock 4 67
					1 box and rod 3 90
					1 - 1/2" straight tail pc. 50
					1 - 1/2" offset tail pc. 50
					1 hr. trucking 75
					18 60

DATE _____

TOWN OF LEXINGTON — BOARD OF PUBLIC WORKS

WATER DIVISION

Sketch of Service Here

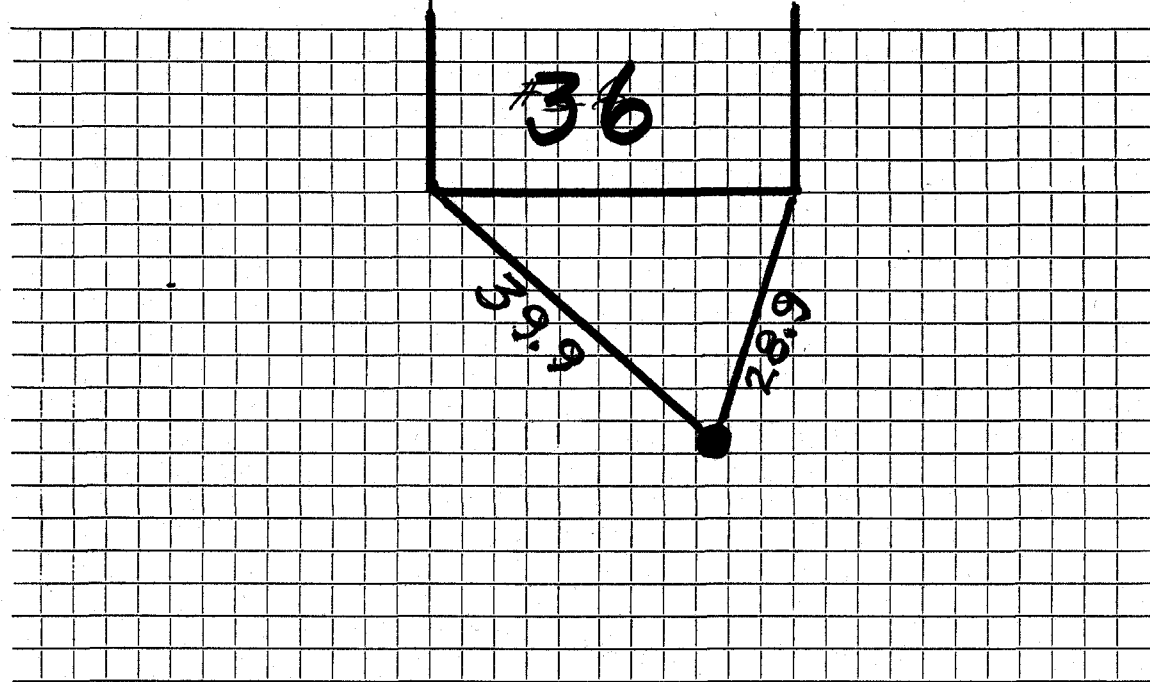

Connection made in Street. Work completed

Remarks:

.....

.....