

WATER SERVICE RECORD


Name **William Cataldo**Service No. **263**Address **39 Rindge Avenue**Location **Lexington**~~Repair~~ **New Service***Comm. 12-3-56*

Date	Material	Amount	Total	Date	Amount
8/31/56	Labor	4 10		8-27-56	Deposit \$ 50 00
	10% Overhead	41	4 51	12-3-56	Refund 21 83
	37' - 3/4" Copper tubing @ .4850	17 95			<u>NON CHARGE</u> 28 17
	1 - 3/4" C x 1/2 I.W.H. stop & waste	4 96			Labor 5 47
	1 hr. trucking @ .75		75		10' - 3/4" Copper tubing @ .4850 4 85
			28 17		1 - 3/4" C. corp-cock 4 64
					1 - 3/4" C. Curb-cock 5 94
					1 box and rod 4 62
					1 1/2 straight tail piece 50
					1 1/2 offset tail piece 50
					<u>26 52</u>

DATE _____

TOWN OF LEXINGTON — BOARD OF PUBLIC WORKS

WATER DIVISION

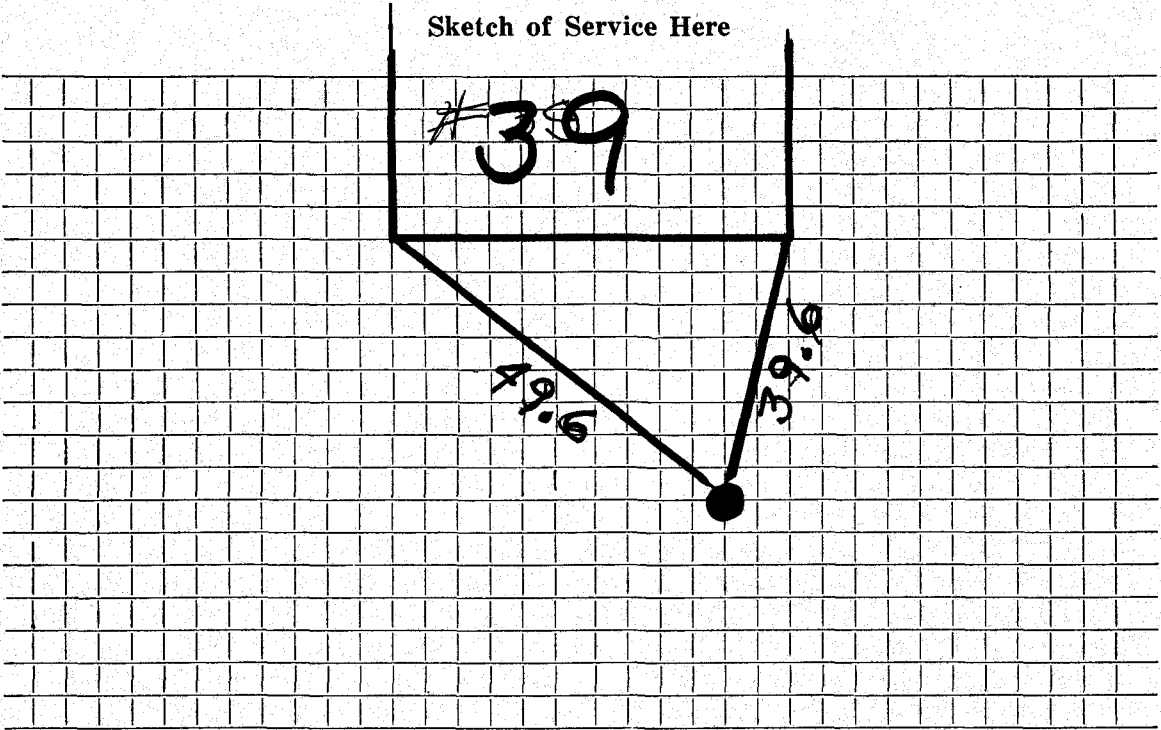

Connection made in Street. Work completed

Remarks:

.....

.....