

Name Jerry Cataldo  
 Address 40-42 Rindge Avenue

Service No. ~~78~~ 2373

Location

Kind of Pipe

Size

Size of Main

~~Repair~~ - Renewal - ~~New Service~~

Location

Date	Material	Amount	Total	Date	Amount
1940					
Oct. 22	2 hrs. @ 60¢	1 20		October 17 1946	8 00
Com 11/18/40	10% Overhead	12	1 32	Deposited	
	20' 3/4" Copper tubing @ 18¢		3 60	3/4 Copper	
	1 3/4" C.x 1/2" I.S. & W.		2 25		
	2 3/4" C.Unions (3 part) @ 90¢		1 80		
	1 hr. trucking @ 75¢		75		
			9 72		
	Charge \$8.00.				
	Labor				

Hadley Press, Inc., Lexington

DATE \_\_\_\_\_

# TOWN OF LEXINGTON—BOARD OF PUBLIC WORKS

## WATER DIVISION

The undersigned applies for a supply of water at No. \_\_\_\_\_ St. and hereby agrees to comply with the rules and regulations as now, or at any future time, established by the Board of Selectmen.

Am't. of Estimate \$ 8<sup>00</sup>


Owner \_\_\_\_\_

Am't. Paid \$ \_\_\_\_\_

Address \_\_\_\_\_

Builder \_\_\_\_\_

Sketch of Service Here

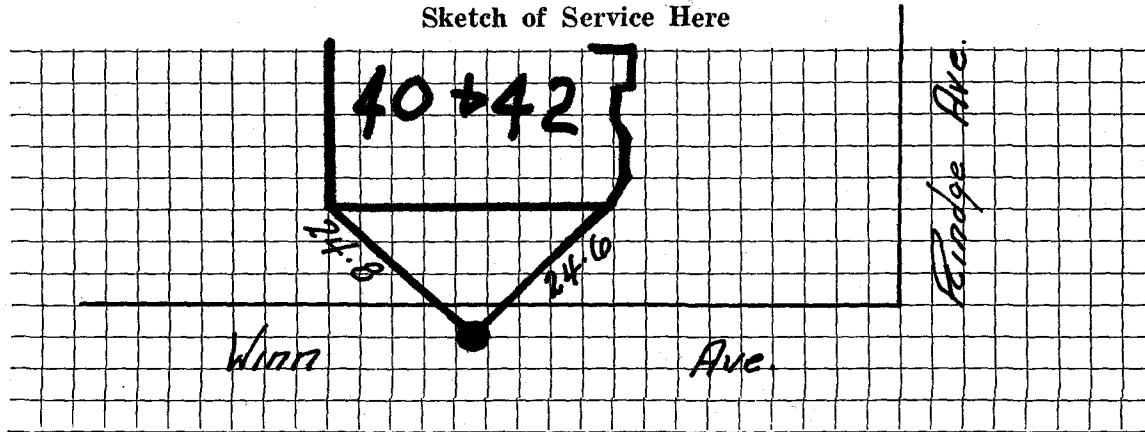

Connection made in \_\_\_\_\_ Street.

Work completed \_\_\_\_\_ 19

Remarks: