

WATER SERVICE RECORD

Name Anthony Cataldo

Service No. 56

Address 47 Rindge Avenue

Location

~~Repair & Renewal~~ - New Service


Comm. 7/22/57

Date	Material	Amount	Total	Date	Amount	
4/16/57	Labor	18 75		4-3-57	Deposit	\$ 75 00
	10% overhead	1 88	20 63	7-22-57	Refund	15 66
	62' - 3/4" Copper tubing @ .4228		26 21			# 59 34
	1 hr. Town Shovel		6 50			
	1 hr. Trucking		3 00	7-14-'61		
	1 hr. Rodgers Trailer		3 00		12' 3/4" Copper	
			59 34		1 3/4" C. Corp Cock	
					1 3/4" C. Curb Cock	
					1 3/4" - 3 Part Union	
					1 Box + Red.	

TOWN OF LEXINGTON — BOARD OF PUBLIC WORKS

WATER DIVISION

Sketch of Service Here

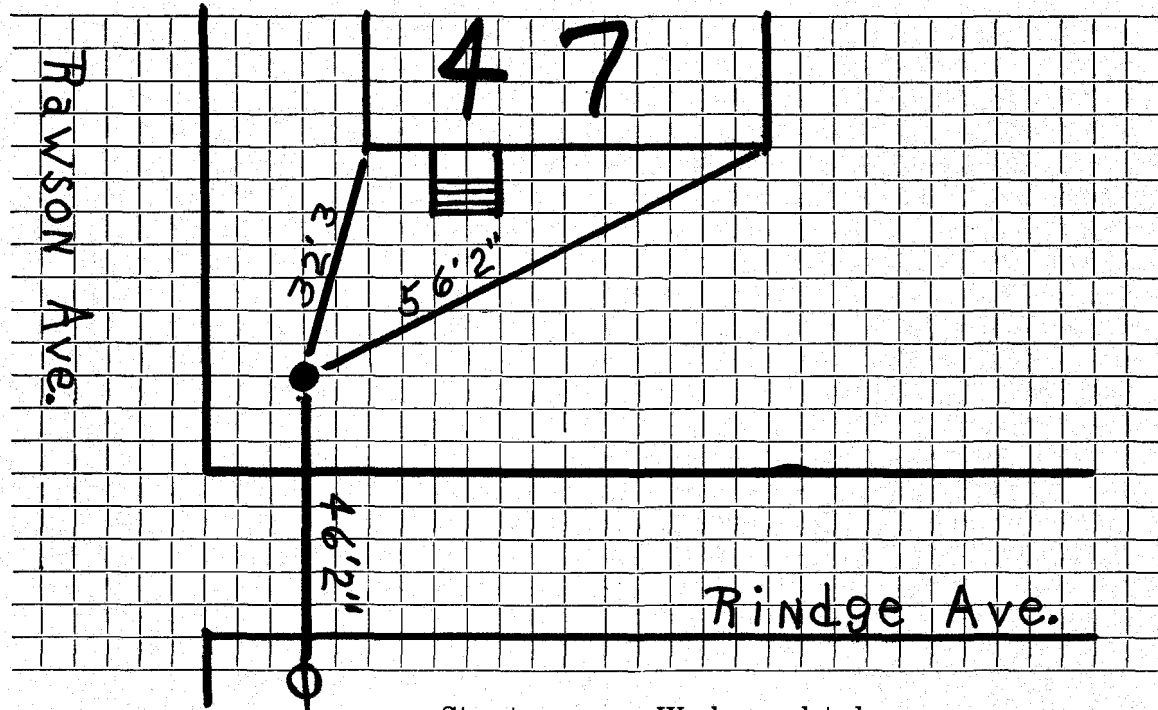

Connection made in Street. Work completed

Remarks:
.....
.....