

FORM 101

WATER SERVICE RECORD

6199

Name **Gabriel Pica**

Service No. 112

Address **1125 RINDGE AVE.**

Location **Lot 200-201 Sta. 9+60 left**

~~Work~~ **New Service**

W.O.# 8240


Comm 2-10-64

Date	Material	Amount	Total	Date		Amount
10/28/68	Labor	2 05		10-15-63	Deposit	50 00
	10% O.H.	21		2-16-64	Retained	41 57
			2 26			8 43
	Owners Copper					
	1 3/4" Cx 1/2 I.W.H. Stop & Waste		6 17		NON CHARGE	
			8 43	8-13-62	Labor	3 48
					15' 3/4" Copper tubing @.42	6 30
					1 3/4" C Corp Cock	4 91
					1 3/4" C Curb Cock	4 90
						25 87
					1 1/2 Straight Tailpiece	50
					1 1/2 Offset Tailpiece	50
						26 87

TOWN OF LEXINGTON — BOARD OF PUBLIC WORKS

WATER DIVISION

Sketch of Service Here

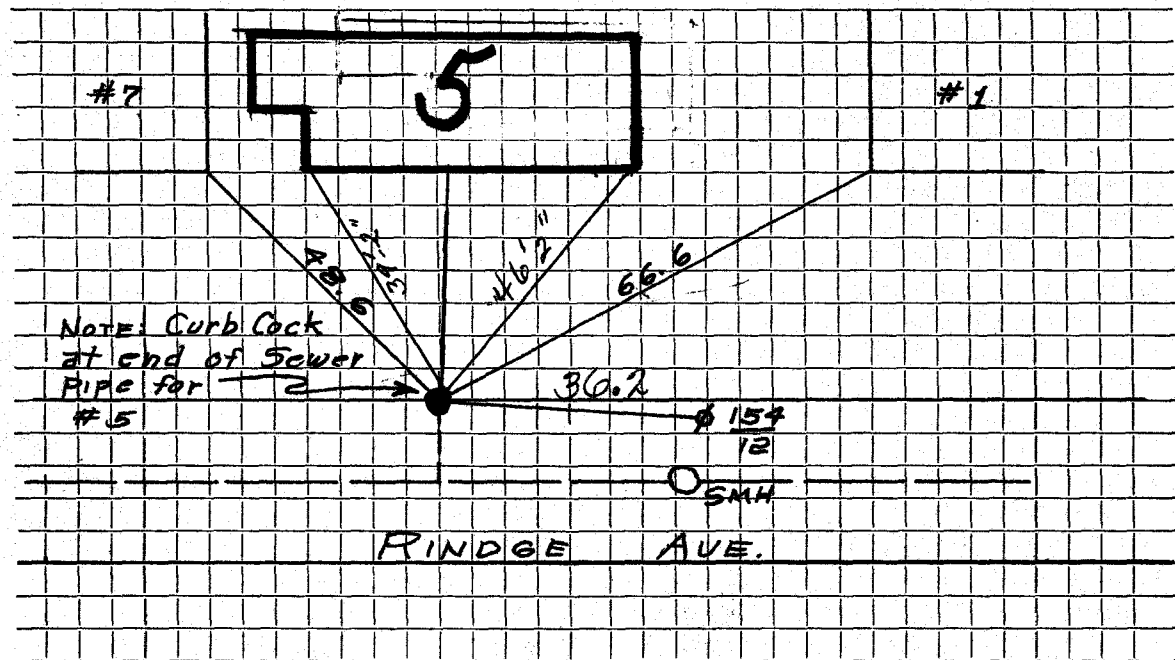

Connection made in Street. Work completed

Remarks:
.....
.....