

WATER SERVICE RECORD

Name William Moretti

Service No. 109

#171
#5007

Address 7 Rindge Avenue

Location

~~Repair~~ ~~Renewal~~ New Service


Comm 8-1-60

Date	Material	Amount	Total	Date	Amount
7-1-60	Labor	1 94		6-30-60	Deposit 25 00
	10% O.H.	19	2 13	8-1-60	Paid by ST#115 1 78
44'	3/4" Copper tubing @42		18 48		26 78
1	3/4" Cx 1/8" I.W.H. Stop&Waste		6 17		
			26 78		NON CHARGE
				8'	3/4" Copper tubing @42 3 36
				1	3/4" C Corp Cock 4 91
				1	3/4" C Curb Cock 6 28
				1	Box & Rod 5 00
				1	1/8" Straight tailpiece 50
				1	1/2" Offset tailpiece 50
					Labor 1 53
					22 08

TOWN OF LEXINGTON — BOARD OF PUBLIC WORKS

WATER DIVISION

Sketch of Service Here

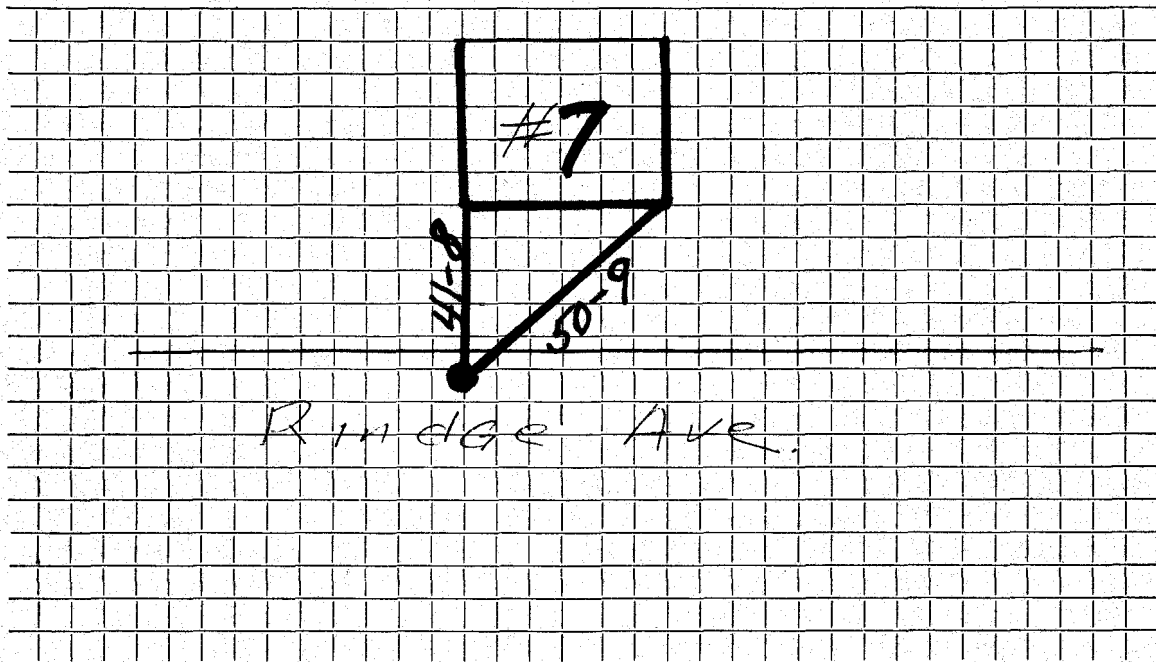

Connection made in Street. Work completed

Remarks:

.....
.....