

## WATER SERVICE RECORD

Name

Service No.

Address

11 Robbins Rd

#7040

Location

Repair—Renewal—New Service

Date	Material	Amount	Total	Date	Amount
10-16-31	<del>           141' 1" C.h. Pipe            8' 1" h.h. Couplings            18' 3/4" Copper            2 1" C. Tol. Unions            1 Stop &amp; Waste         </del>			10/16/31 141 - 1" CL Pipe	
3/13/07	repaired main to curb 3/4" copper				


DATE \_\_\_\_\_

TOWN OF LEXINGTON — BOARD OF PUBLIC WORKS

WATER DIVISION

new curb installed  
 1' from old  
 curb new  
 buff box  
 on ~~the~~ new  
 curb  
 Old curb box  
 removed  
 # sewer under  
 water line

Sketch of Service Here

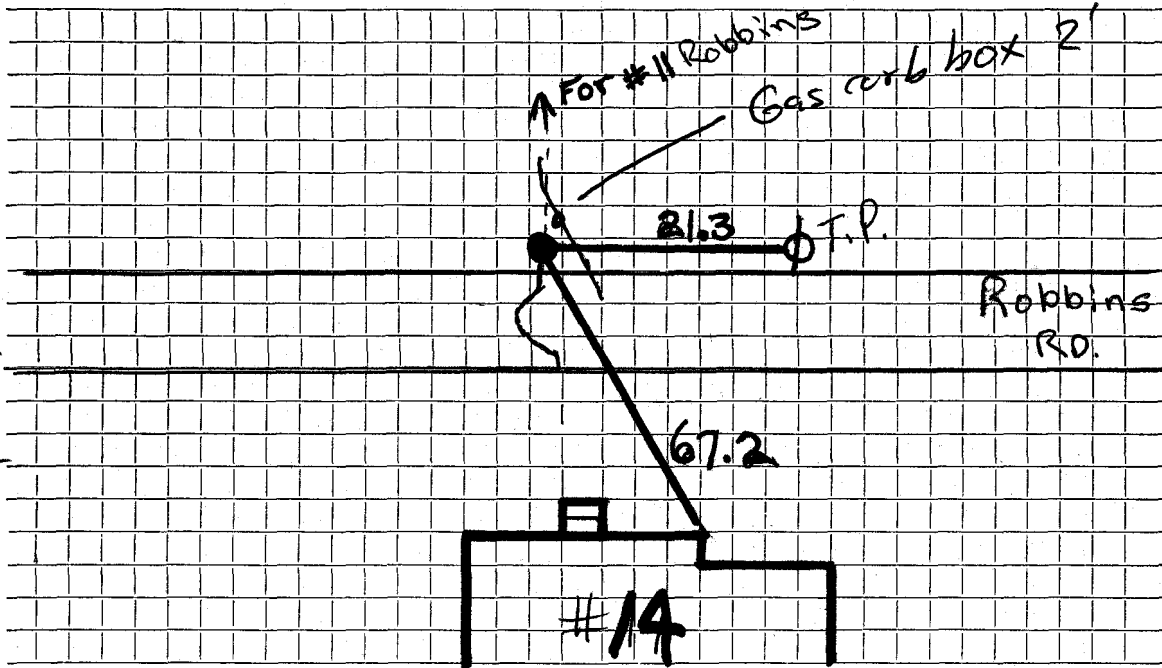

Connection made in ..... Street. Work completed .....

Remarks: Original Service 10-16-31 .....