


DATE _____

TOWN OF LEXINGTON — BOARD OF PUBLIC WORKS
WATER DIVISION

Sketch of Service Here

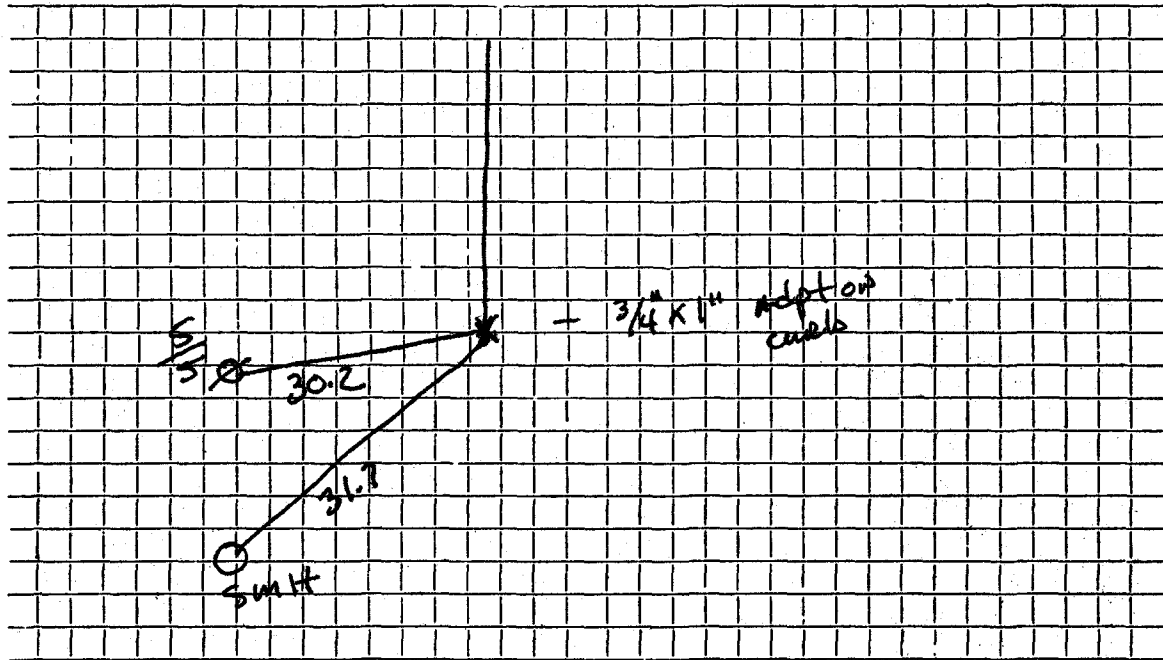

Connection made in Street. Work completed

Remarks: 12.7.99 House torn down new 1" service put in from curb

Old Iron ^{Gas} service above water into curb